21607093000 NO. 10WO

FIELD SURVEY NOTES
PRESERVATION OF LANDMARKS
(Pursuant to Section 59.635(7) Wisconsin Statutes

State Highway Commission of Wisconsin
Form E-D-707-65

COUNTY: LA CROSSE		
TOWN: ONALASKA.		
HIGHWAY: S.T.H. 157		
SECTION: 10	TOWNSHIP: T16N	RANGE: R7W
TYPE OF LANDMARK: 3/4" IRON PIPE SET BY GREG HOFMEISTER NOV. 1980		

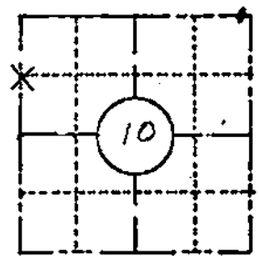

LOCATION SKETCH
(Location of landmark indicated by "x")

This space for copy of field notes or ties to the above described landmarks

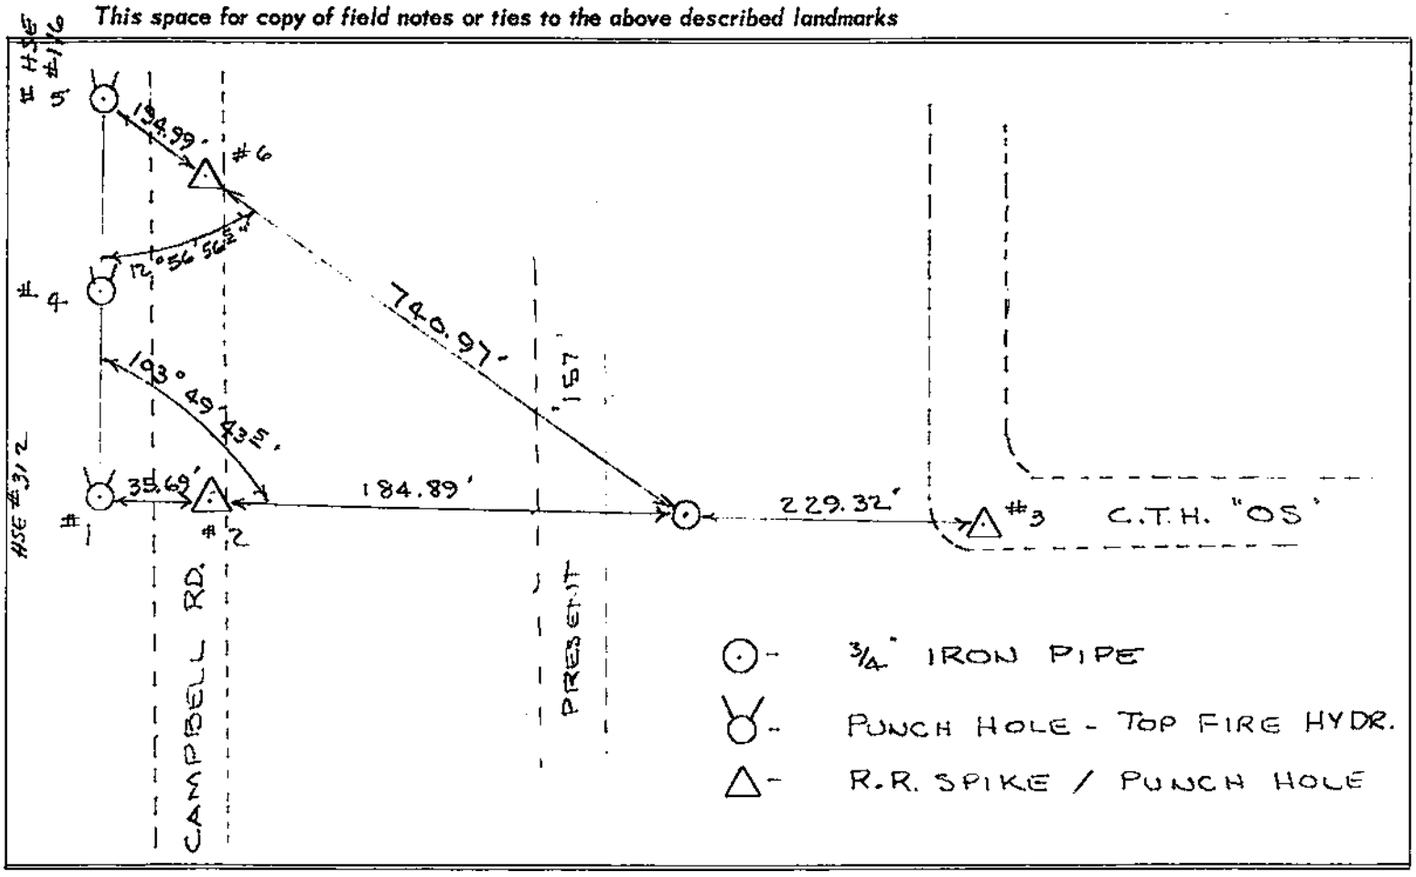

FILED UNDER PROJECT NUMBER 1070-04-74			COUNTY CLERK'S OFFICE COUNTY OF WISCONSIN } SS
SHC DISTRICT OFFICE NUMBER # 5	CITY LA CROSSE	COUNTY LA CROSSE	DATE RECEIVED FOR RECORD / DATE COPY SENT TO COUNTY SURVEYOR
~~LOCATED OR ESTABLISHED~~ BY (PERPETUATED) NAME DERALD E. KADING #1064 TITLE SURVEY COORDINATOR DATE 7-26-84			SIGNATURE OF COUNTY CLERK

PRESERVATION OF LANDMARKS PAGE _____