21607190000

U. S. PUBLIC LAND SURVEY MONUMENT RECORD

SECTION 29 T 16 N, R 7 W, ~~TOWN~~ CITY OF LA CROSSE

LA CROSSE COUNTY

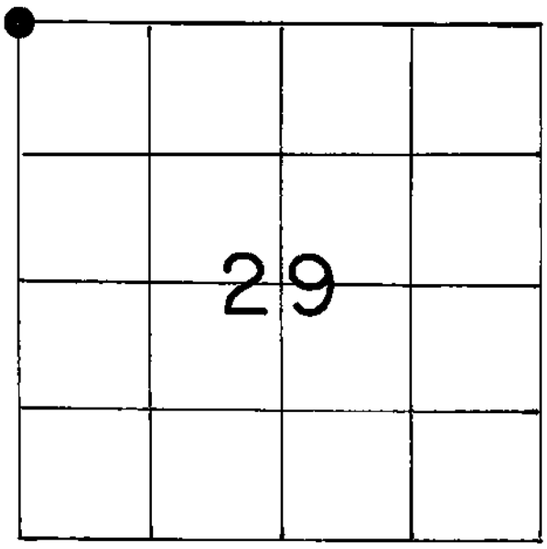

LOCATION OF LANDMARK

South Zone - 1927 - as per D.O.T.

WISCONSIN COORDINATE SYSTEM	
North	673,396.809
East	1,670,349.474
Theta Angle	
Horiz. Order	
Vert. Order	

TYPE OF LANDMARK
Existing 1½" I.P. in concrete.

BEARINGS ARE REFERENCED TO

Crew: WILLIAM C. JUNG
PETER F. FOLLANSBEE

Date: 3/30/1992

Describe any record evidence, monument evidence, testimonial evidence or any other material evidence you considered and whether the monument was found or restored through acceptance of an obliterated evidence location.

An iron pipe set in concrete was fd. at the corner. This corner location had been used in previous surveys. I accepted this pipe as the best available evidence of the original government corner position. The pipe was pointed out to me by Wilbur Clark when he was still with the LaCrosse City Engr. Dept.

Describe or show any material discrepancy between the location of the restored corner and that of the corner previously restored or reestablished.

None Known.

RECORD OF DURABLE WITNESS MONUMENTS

NO	DESCRIPTION	BEARING	DISTANCE
1	Set P.K. Nail in SW-side 11" Evergreen	Southeasterly	58.67 Ft.
2	Set P.K. Nail in NW-side 12" Evergreen	Easterly	62.16 Ft.
3	Distance to S.W. corner of concrete pad	Northeasterly	37.24 Ft.
4	Distance to center of a small manhole	Northwesterly	106.88 Ft.

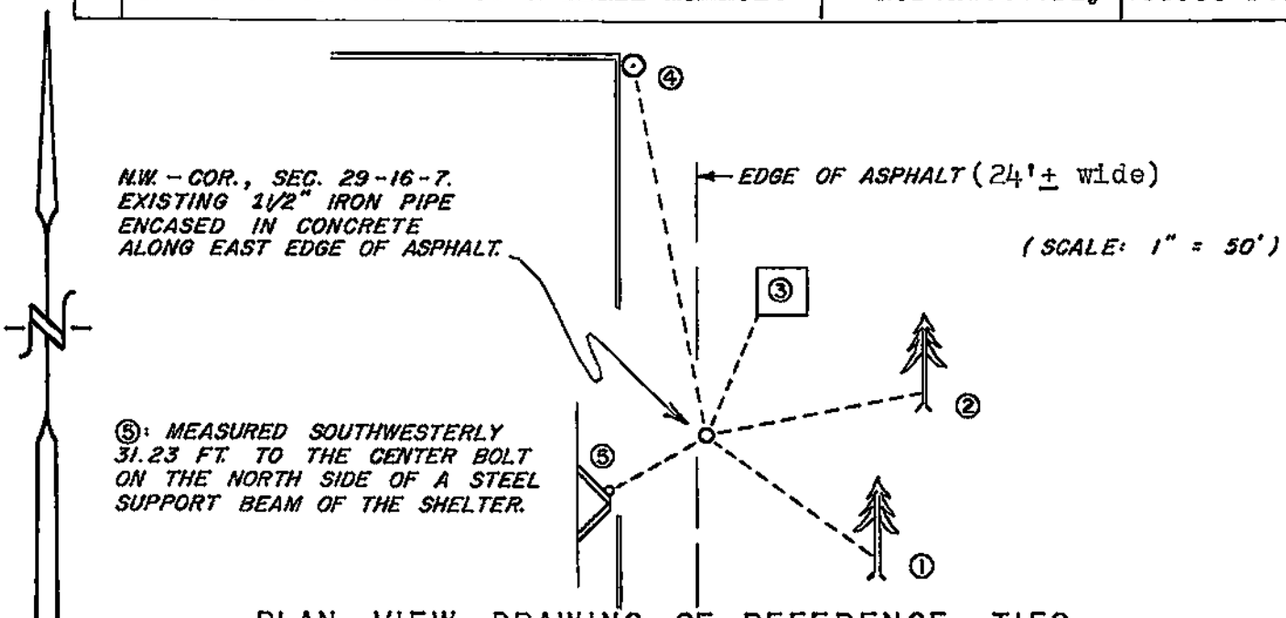

PLAN VIEW DRAWING OF REFERENCE TIES

MAP SHOWING DISTANCE AND DIRECTION TO OTHER PUBLIC LAND SURVEY CORNERS USED FOR REESTABLISHING THE CORNER

NO SECTION MEASUREMENTS MADE BY ME AT THIS TIME. LOCATION CONFIRMED BY W. CLARK, R.L.S. .

I, William C. Jung, Deputy County Surveyor
HEREBY CERTIFY THAT THE CORNER LOCATION SHOWN ON THIS RECORD WAS DETERMINED BY ME OR UNDER MY DIRECTION AND CONTROL AND THAT THIS U. S. PUBLIC LAND SURVEY MONUMENT RECORD IS CORRECT AND COMPLETE TO THE BEST OF MY KNOWLEDGE AND BELIEF.

William C. Jung
Signature

December 31, 1992
Date

WISCONSIN
WILLIAM C. JUNG
S-1323
ONALASKA, WIS.
LAND SURVEYOR

Seal