NO. 111

21607210000

U. S. PUBLIC LAND SURVEY MONUMENT RECORD

SECTION 21 T 16 N, R 7 W, TOWN OF Medary

LA CROSSE COUNTY

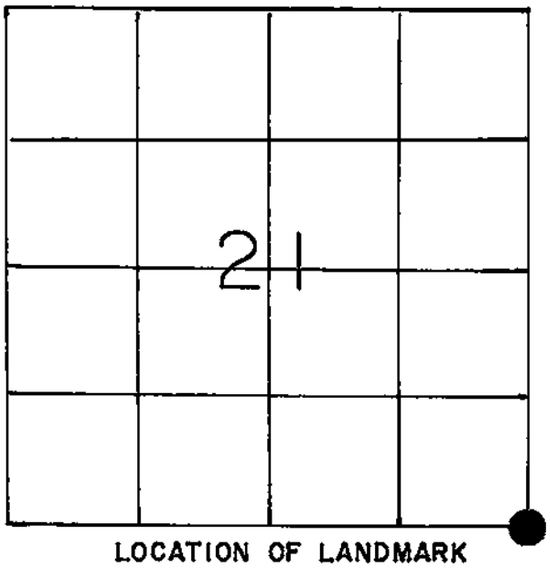

LOCATION OF LANDMARK

WISCONSIN COORDINATE SYSTEM	
North	673,143.491 (1927 as per D.O.T.)
East	1,680,869.227
Theta Angle	
Horiz. Order	
Vert. Order	

TYPE OF LANDMARK
Existing Berntsen monument

BEARINGS ARE REFERENCED TO

Crew: William C. Jung
Peter F. Follansbee

Date: April 26, 1990

Describe any record evidence, monument evidence, testimonial evidence or any other material evidence you considered and whether the monument was found or restored through acceptance of an obliterated evidence location.

We found at the section corner a Berntsen monument set by Lampman in 1982.

Describe or show any material discrepancy between the location of the restored corner and that of the corner previously restored or reestablished.

At a magnetic bearing of S67°E and a slope distance of 50.55' from the corner we found a 1" iron pipe at a fence corner. The fences went North and West. We also found four bearing trees for the pipe. Lampman obviously did not agree with this corner. I can see why.

RECORD OF DURABLE WITNESS MONUMENTS

NO	DESCRIPTION	Magnetic BEARING	DISTANCE
1	P.K. nail in double blazed 12" oak(?)	S19°W	20.94
2	" 11" "	N41°W	21.92
3	" 14" "	N16°E	10.55
4	" 10" "	N56°E	24.20

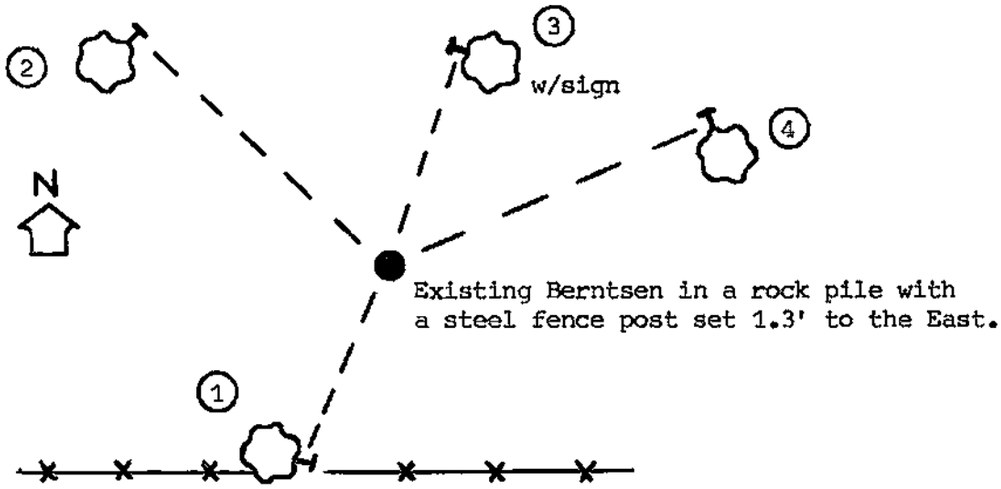

(not to scale)

PLAN VIEW DRAWING OF REFERENCE TIES

MAP SHOWING DISTANCE AND DIRECTION TO OTHER PUBLIC LAND SURVEY CORNERS USED FOR REESTABLISHING THE CORNER

No section measurements made by me at this time. Refer to Lampman 1982 section data.

I, William C. Jung, Deputy County Surveyor,
HEREBY CERTIFY THAT THE CORNER LOCATION SHOWN ON THIS RECORD WAS DETERMINED BY ME OR UNDER MY DIRECTION AND CONTROL AND THAT THIS U. S. PUBLIC LAND SURVEY MONUMENT RECORD IS CORRECT AND COMPLETE TO THE BEST OF MY KNOWLEDGE AND BELIEF.

William C. Jung
Signature

February 12, 1991
Date

WISCONSIN
WILLIAM C. JUNG
S-1323
ONALASKA, WIS.
LAND SURVEYOR

Seal