NO. 102

21607232000

U. S. PUBLIC LAND SURVEY MONUMENT RECORD

SECTION 23 T 16 N, R 7 W, TOWN OF MEDARY

LA CROSSE COUNTY

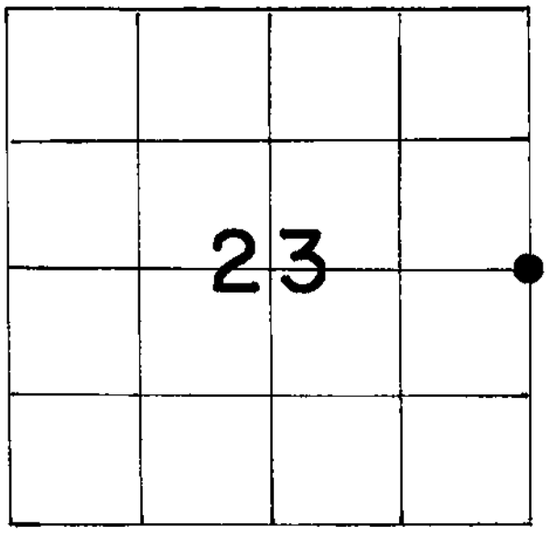

LOCATION OF LANDMARK

WISCONSIN COORDINATE SYSTEM
North
East
Theta Angle
Horiz. Order
Vert. Order

TYPE OF LANDMARK P.K. nail over ex. IRON PIPE

BEARINGS ARE REFERENCED TO

Crew: William Jung
Perry Dahl
8/21/85

Crew: William Jung
Peter Follansbee
5/19/06 ******

Describe any record evidence, monument evidence, testimonial evidence or any other material evidence you considered and whether the monument was found or restored through acceptance of an obliterated evidence location.

Dick Berg set an iron pipe at this corner in February of 1984. Gary Watts used this pipe in a survey done in April of 1985. I agree with the procedure used by Berg to set the corner and thus accepted the pipe as the best available evidence of the original government corner position.

****** We found the pipe and pounded it down in the pavement. A P.K. nail with washers was set over it.

Describe or show any material discrepancy between the location of the restored corner and that of the corner previously restored or reestablished.

None known.

RECORD OF DURABLE WITNESS MONUMENTS

NO	DESCRIPTION	MAGNETIC BEARING	DISTANCE
1	ex. 1" IRON PIPE (set on South side of post)	N1°E	24.74'
2	Set NAIL IN HACK OF 19" WHITE PINE	S73°E	89.17'
3	P.K. NAIL IN HACK OF 5" CEDAR TREE	N21°E	24.55'
4	Set NAIL IN double OAK	S78°E	65.54'

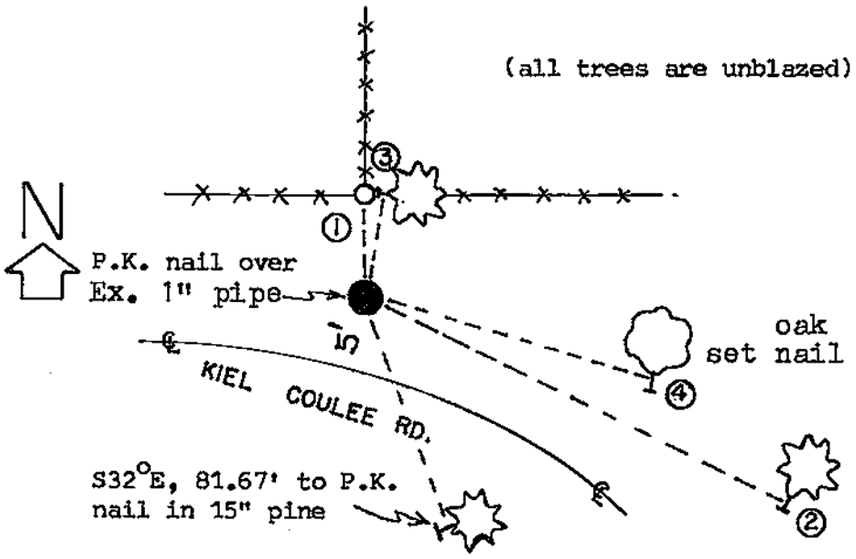

PLAN VIEW DRAWING OF REFERENCE TIES

MAP SHOWING DISTANCE AND DIRECTION TO OTHER PUBLIC LAND SURVEY CORNERS USED FOR REESTABLISHING THE CORNER

No measurements made by me at this time. Refer to Berg's maps, dated 2/22/84.

I, William C. Jung, ~~Deputy~~ County Surveyor,
HEREBY CERTIFY THAT THE CORNER LOCATION SHOWN ON THIS RECORD WAS DETERMINED BY ME OR UNDER MY DIRECTION AND CONTROL AND THAT THIS U. S. PUBLIC LAND SURVEY MONUMENT RECORD IS CORRECT AND COMPLETE TO THE BEST OF MY KNOWLEDGE AND BELIEF.

William C. Jung — 2/14/86
Signature — Date

Revised: 5/26/06 WCJ

WISCONSIN
WILLIAM C. JUNG
S-1323
ONALASKA, WIS.
LAND SURVEYOR

Seal