21607300000

U. S. PUBLIC LAND SURVEY MONUMENT RECORD

SECTION 32 T 16 N, R 7 W, ~~TOWN~~ CITY OF LA CROSSE,

LA CROSSE COUNTY

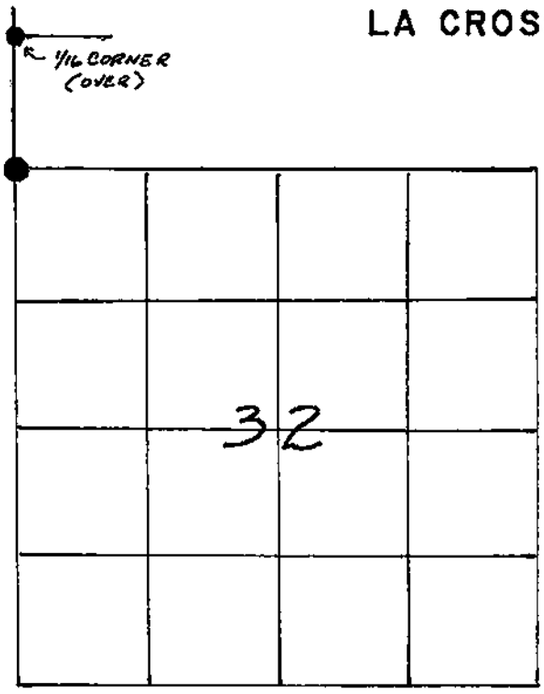

LOCATION OF LANDMARK

WISCONSIN COORDINATE SYSTEM
North
East
Theta Angle
Horiz. Order
Vert. Order
TYPE OF LANDMARK SEE BELOW-
BEARINGS ARE REFERENCED TO ALIGNMENT CONTROL DIAGRAM, D.O.T. PROJECT 5250-05-73, SHEET 2.36, COPELAND AVENUE, APPROVED 1988.

Describe any record evidence, monument evidence, testimonial evidence or any other material evidence you considered and whether the monument was found or restored through acceptance of an obliterated evidence location.

COPPER POINT IN SIDEWALK. (HAD TO BE REMOVED BECAUSE OF 1988 STREET CONSTRUCTION.)

Describe or show any material discrepancy between the location of the restored corner and that of the corner previously restored or reestablished.

NONE.

TYPE OF LANDMARK:

3½"Ø ALUM. MONUMENT.

"WIS. D.O.T."

"VERTICAL CONTROL"

"UNLAWFUL TO DISTURB"

30 29
31 + 32 ← STAMPED NO'S.

RECORD OF DURABLE WITNESS MONUMENTS

NO	DESCRIPTION	BEARING	DISTANCE
1	NAIL & TAB IN BIT. PARKING LOT	S88°-27'-38"W	15.00'
2	" " " " " " "	N37°-17'-46"W	71.88'
3			
4			

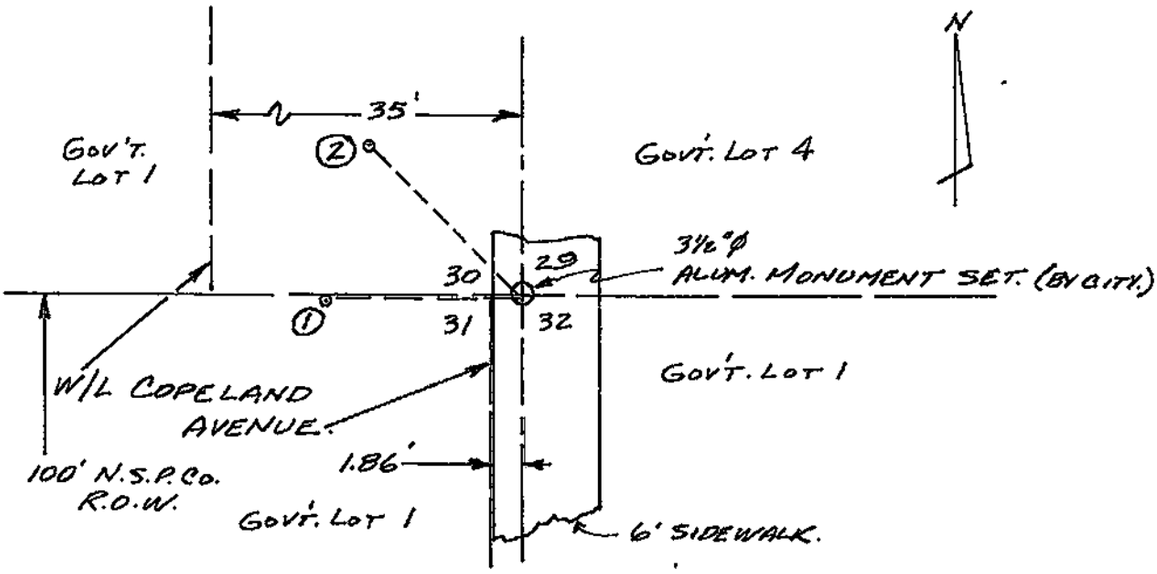

PLAN VIEW DRAWING OF REFERENCE TIES

MAP SHOWING DISTANCE AND DIRECTION TO OTHER PUBLIC LAND SURVEY CORNERS USED FOR REESTABLISHING THE CORNER

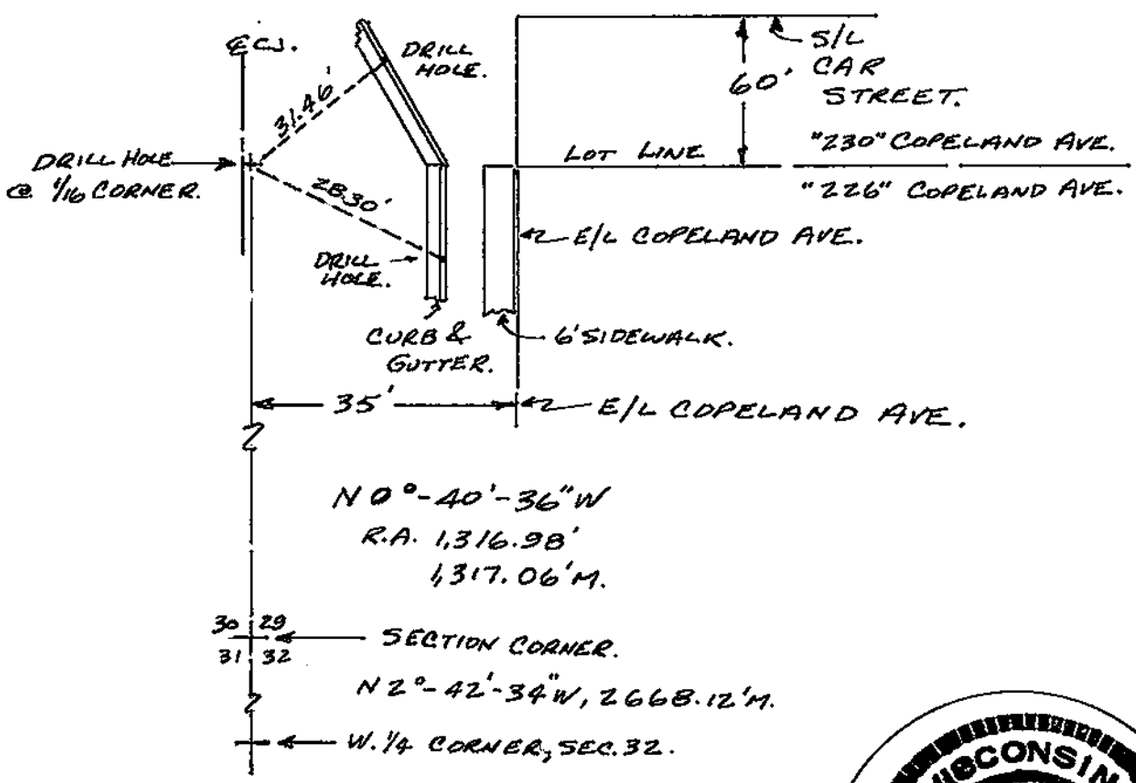

I, WILBUR. L. CLARK, R.L.S. 914,
HEREBY CERTIFY THAT THE CORNER LOCATION SHOWN ON THIS RECORD WAS DETERMINED BY ME OR UNDER MY DIRECTION AND CONTROL AND THAT THIS U. S. PUBLIC LAND SURVEY MONUMENT RECORD IS CORRECT AND COMPLETE TO THE BEST OF MY KNOWLEDGE AND BELIEF.

Wilbur L. Clark - 10-21-'88.
Signature Date

WISCONSIN WILBUR L. CLARK S-00914 LA CROSSE, WIS. LAND SURVEYOR

Seal

NO. 141 (4)

Tie Sheet, City of La Crosse

Section 32 Township 16 N Range 7 W

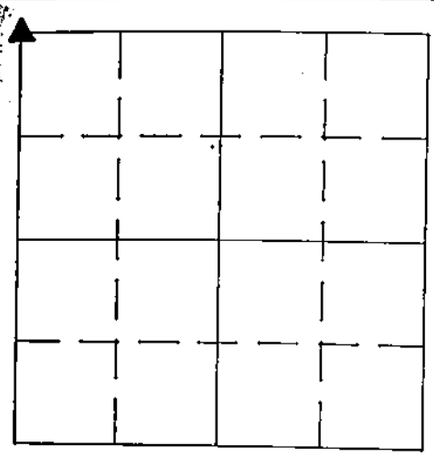

Project Section Corner
Sta No
Monument
Coord. System
North
East
Elev
Surveyor County

Comments:

Date

Space for copy of field notes or ties to above described monument:

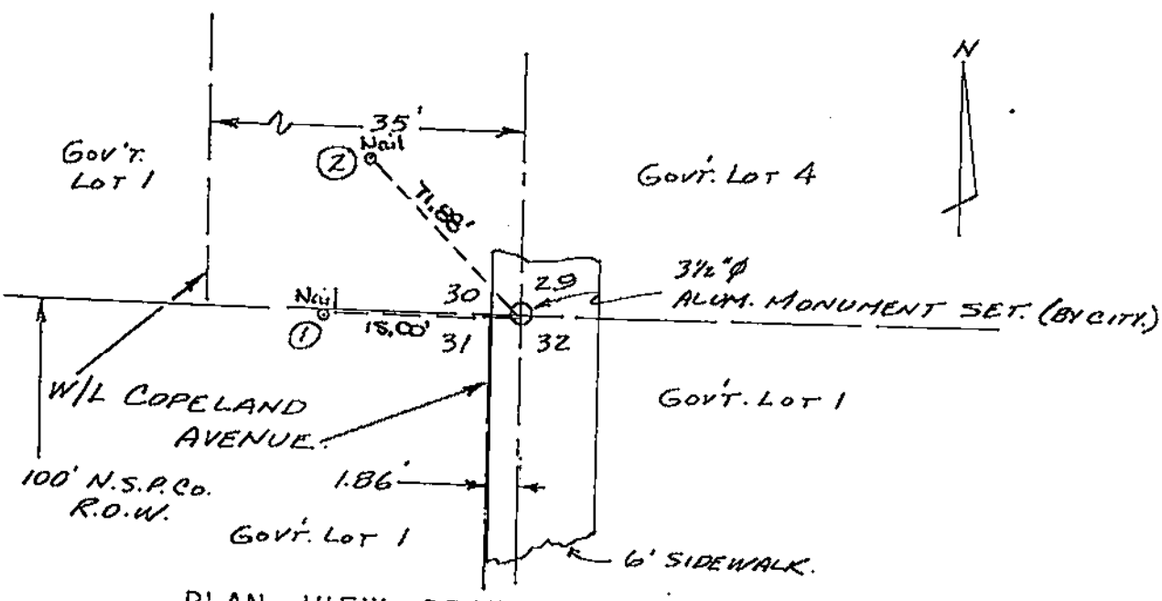

PLAN VIEW DRAWING OF REFERENCE TIES

MAP SHOWING DISTANCE AND DIRECTION TO OTHER PUBLIC LAND SURVEY CORNERS USED FOR REESTABLISHING THE CORNER