21607320000

U. S. PUBLIC LAND SURVEY MONUMENT RECORD

SECTION 33 (S.W. CORNER) T 16 N, R 7 W, ~~TOWN~~ CITY OF LACROSSE

LA CROSSE COUNTY

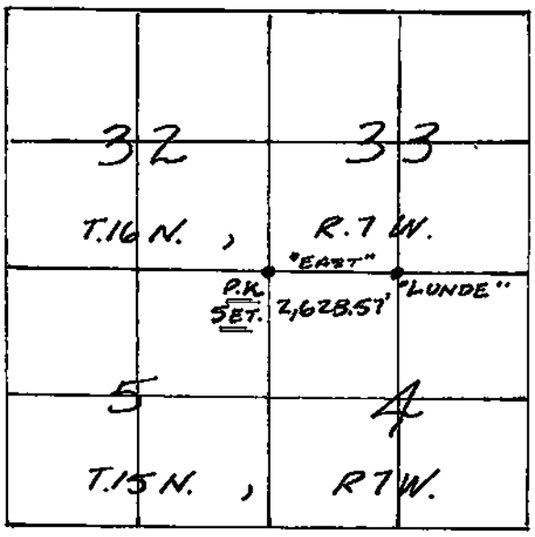

LOCATION OF LANDMARK

WISCONSIN COORDINATE SYSTEM
North
East
Theta Angle
Horiz. Order
Vert. Order
TYPE OF LANDMARK P.K. NAIL SECTION CORNER, SET.
BEARINGS ARE REFERENCED TO S/L OF SECTION 33, ASSUMED "EAST"

Describe any record evidence, monument evidence, testimonial evidence or any other material evidence you considered and whether the monument was found or restored through acceptance of an obliterated evidence location.

"TIE" SHEET (COPY ENCLOSED) FROM "MONUMENT" LOOSE LEAF FIELD BOOK, ENGR. DEPT., CITY OF LACROSSE. DRILL HOLE "TIE" EXISTED ON S/S MAIN ST.; DRILL HOLE WAS MISSING ON N/S OF MAIN ST. BECAUSE CURB HAD BEEN REPLACED, BUT 30' "TIE" FIT ON TOP OF NEW CURB AT ENTRANCE WALK.

SET: JULY, 1991.

Describe or show any material discrepancy between the location of the restored corner and that of the corner previously restored or reestablished.

N/A

RECORD OF DURABLE WITNESS MONUMENTS

NO	DESCRIPTION	BEARING	DISTANCE
1	DRILL HOLE, TOP OF CURB & GUTTER	N 33°-41'-24" E	27.00'
2	" " , " " " " "	S 49°-19'-00" E	34.00'
3	1" I.P. ON S/L MAIN ST.	S 2°-54'-30" W	40.25'
4	"LUNDE" MON'T., SOUTH 1/4 CORNER OF SECTION 33.	"EAST"	2,628.57'
5	CONCRETE NAIL & TAB (AT ℄ 21ST STREET)	"EAST"	981.86'

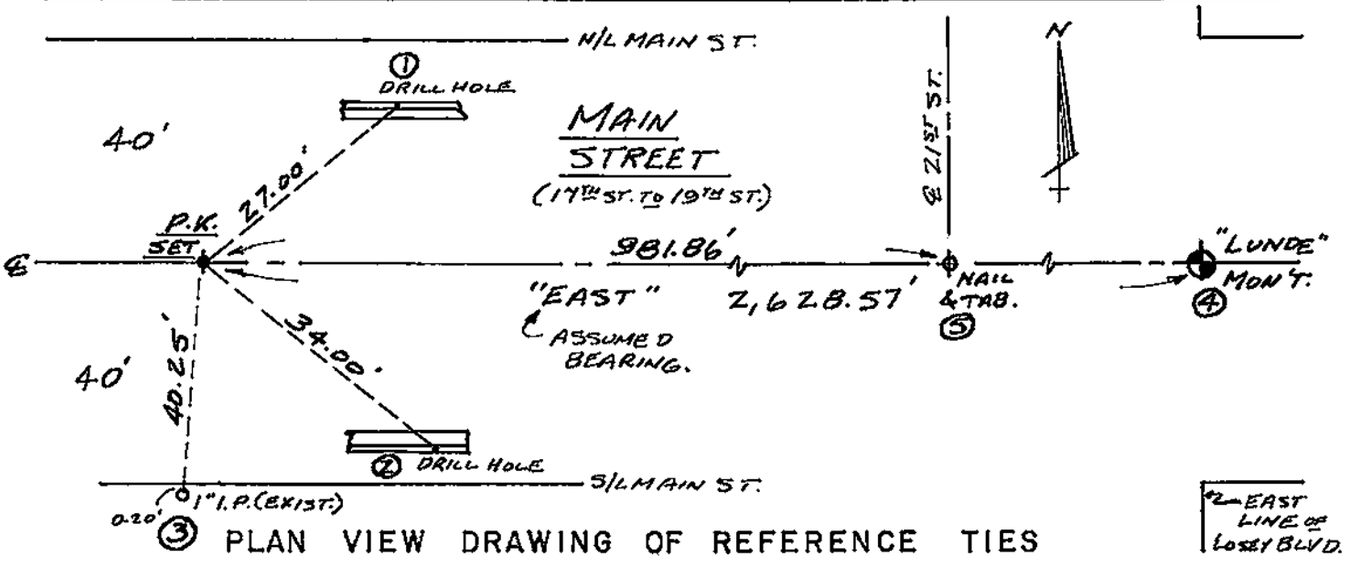

PLAN VIEW DRAWING OF REFERENCE TIES

MAP SHOWING DISTANCE AND DIRECTION TO OTHER PUBLIC LAND SURVEY CORNERS USED FOR REESTABLISHING THE CORNER

N/A

I, WILBUR L. CLARK

HEREBY CERTIFY THAT THE CORNER LOCATION SHOWN ON THIS RECORD WAS DETERMINED BY ME OR UNDER MY DIRECTION AND CONTROL AND THAT THIS U. S. PUBLIC LAND SURVEY MONUMENT RECORD IS CORRECT AND COMPLETE TO THE BEST OF MY KNOWLEDGE AND BELIEF.

Wilbur L. Clark 12-4-1991.

Signature Date

WISCONSIN WILBUR L. CLARK S-00914 LA CROSSE, WIS. LAND SURVEYOR

Seal