21608013000

FIELD SURVEY NOTES
PRESERVATION OF LANDMARKS
(Pursuant to Section 59.635(7) Wisconsin Statutes

State Highway Commission of Wisconsin
Form E-D-707-65

COUNTY: LA CROSSE		
TOWN: CAMPBELL		
HIGHWAY: C.T.H. "B.W."		
SECTION: 6	TOWNSHIP: 16 N	RANGE: 7 W
TYPE OF LANDMARK: WIS. D.O.T. 30" CAST ALUMINUM MONU.		

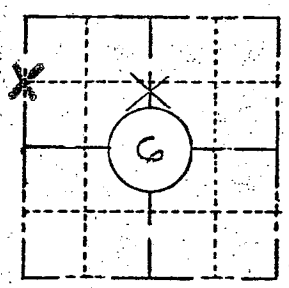

LOCATION SKETCH
(Location of landmark indicated by "x")

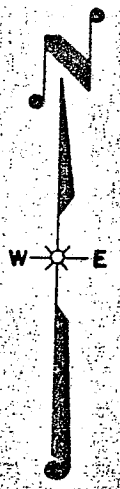

This space for copy of field notes or ties to the above described landmarks

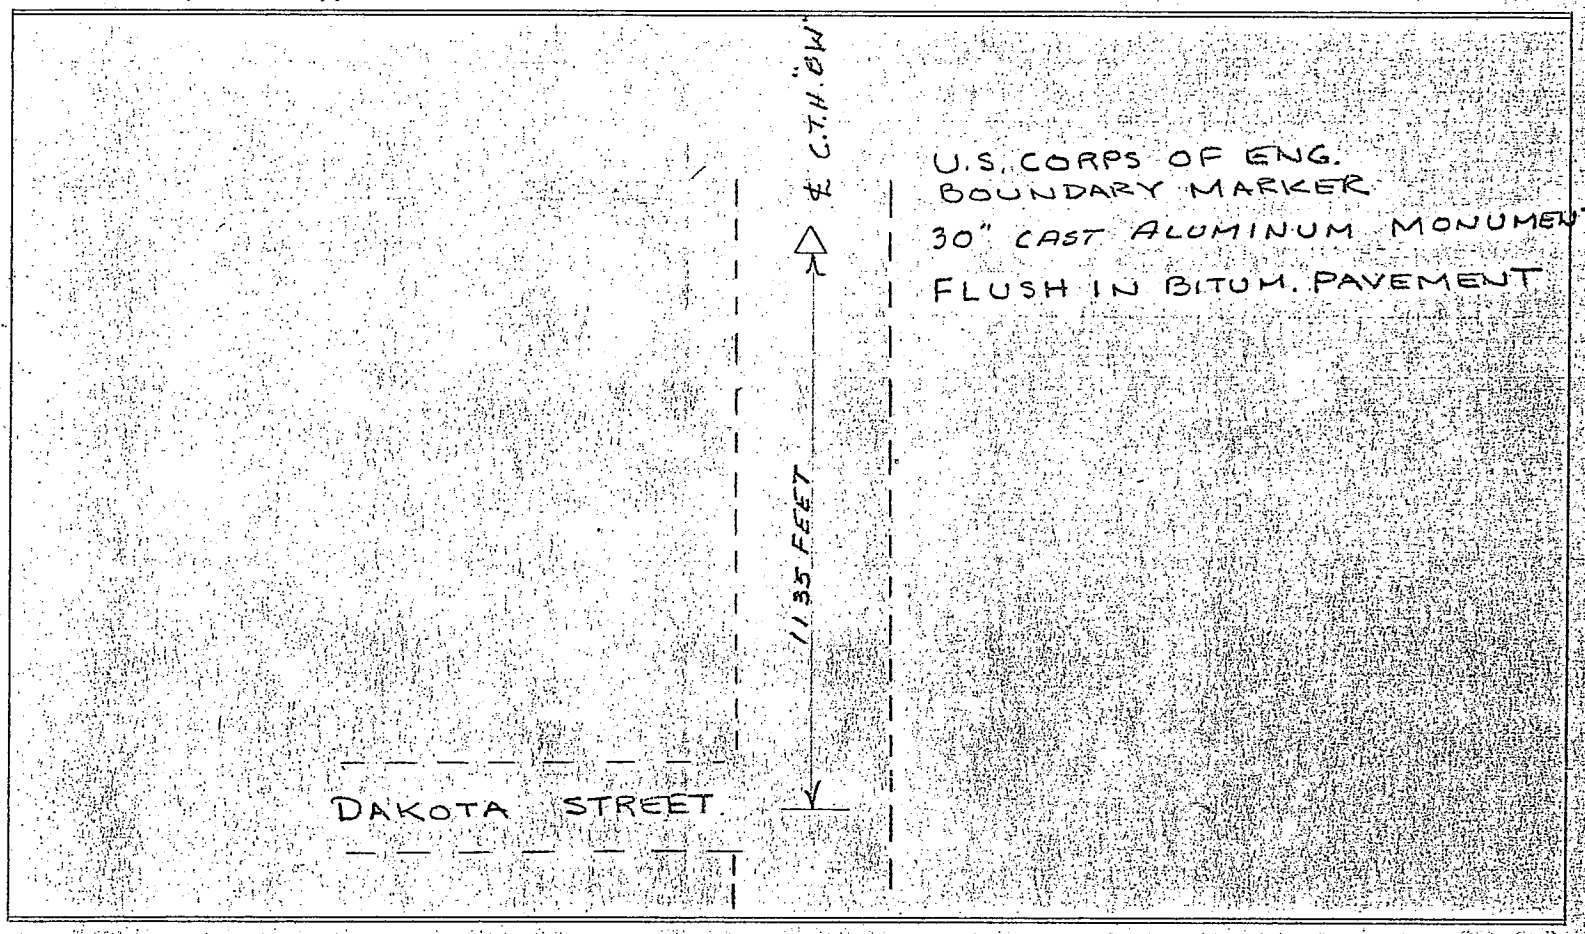

FILED UNDER PROJECT NUMBER		
SHC DISTRICT OFFICE NUMBER: 5	CITY: LA CROSSE	COUNTY: LA CROSSE
~~LOCATED OR ESTABLISHED BY~~		
NAME: DERALD E. KADING		
TITLE: SURVEY COORDINATOR	DATE: 11-24-76	

COUNTY CLERK'S OFFICE COUNTY OF _____ WISCONSIN } SS	
DATE RECEIVED FOR RECORD	DATE COPY SENT TO COUNTY SURVEYOR
SIGNATURE OF COUNTY CLERK	