NO. 130

21705252000

CERTIFICATE

I, Harley A. Sime, do hereby certify that on the 25 day of September 19 75 I found (~~evidence~~) (no evidence) of the W¼ corner of Sec. 30, T 17 N, R 4 W, Fourth Principal Meridian, and I re-established said corner according to the Wisconsin Statutes as shown and described hereon.

Dated this 5 day of March 19 76.

COUNTY SURVEYOR

Title

CERTIFIED LAND CORNER

No. 94

History of original corner establishment:

Description of corner evidence found:

Accepted the existing field conditions, a strong 4-way fence corner as the best available field evidence. This location matched the remainder to the section well.

COUNTY SURVEYOR FORM NO. 1

Description of corner and witness monuments, references and accessories used to perpetuate the original or re-established location of this corner:

Set Harrison, up 3"

Witnesses to corner location:

D. J. Malliet - Crew Chief RLS

A. Lueck

WISCONSIN HARLEY A. SIME S-355 TOMAH, WIS. LAND SURVEYOR

NOTE: All trees blazed and with nail & caps

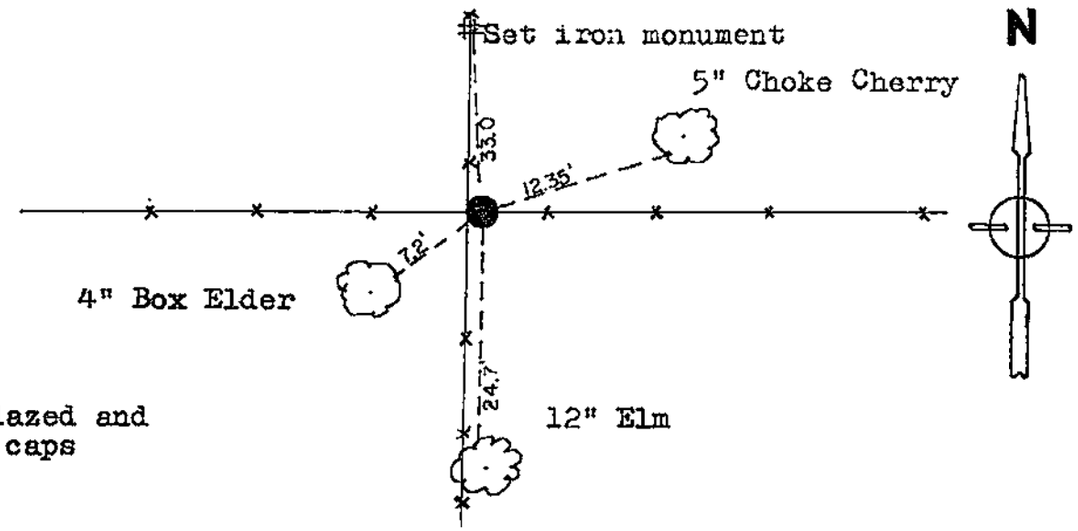

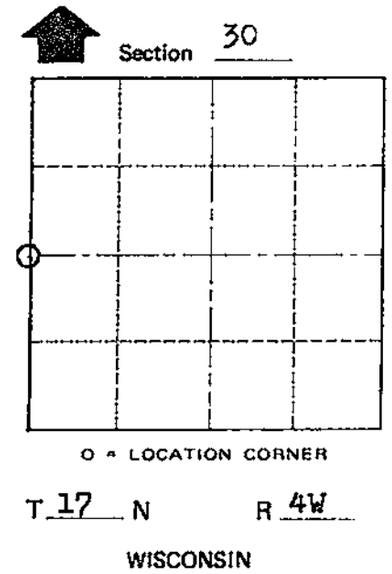

SURVEY CONTROL ORDER

Horizontal	
Vertical	

WISCONSIN COORDINATE SYSTEM

Corner	East (X)	North (Y)	Elevation (Z)	Zone
Control Sta. Name				

City, Village or Town Sparta

County of Monroe