NO. 39

21707010000

RECORD OF LAND CORNER PERPETUATION

No. _____

STATE OF WISCONSIN
County of La Crosse } ss.

I, Ray P. Pelishek, hereby certify that the information shown hereon correctly describes the original corner, resurvey information, evidence found, type of monument found or placed, and witness monuments and accessories used to perpetuate the location of the original or established corner.

Dated this 10th day of December, 19 80.

at La Crosse, Wisconsin.

Ray P. Pelishek

La Crosse County Surveyor
Title

COUNTY: LA CROSSE		
TOWN: ONALASKA-HAMILTON		
HIGHWAY:		
SECTION: 1-6-7-12	TOWNSHIP: 17 N	RANGE: 7 W - 6 W
TYPE OF LANDMARK: La Crosse County Survey Marker		

Date of Survey Nov. 26, 1980

Drafted by T. Henkel

Date Dec. 10, 1980

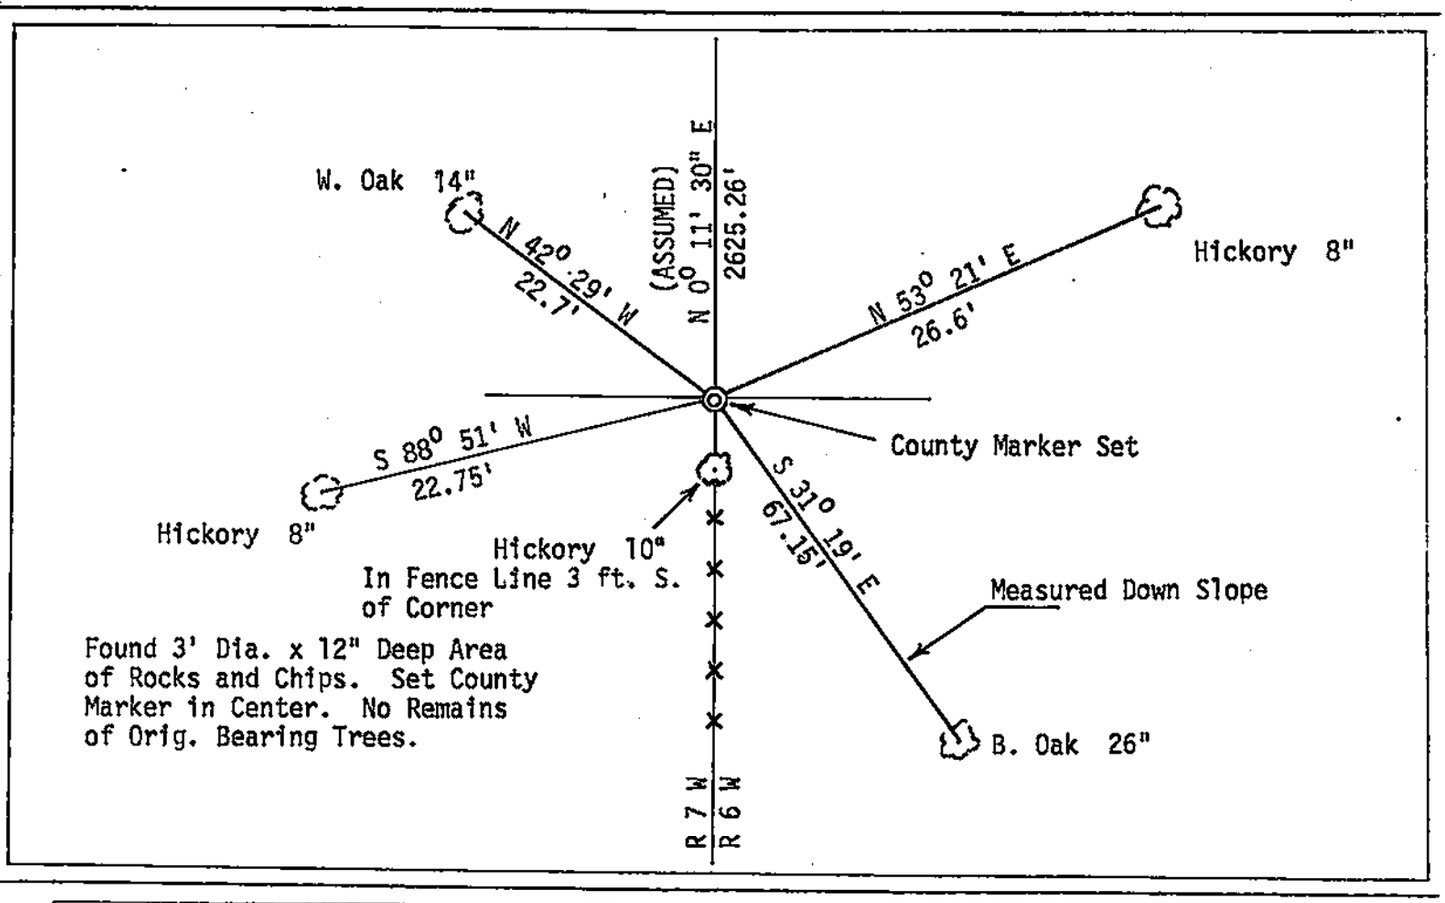

WISCONSIN COORDINATE SYSTEM	
North	Zone
East	
Elevation	Theta Angle
Vertical control order	
Horizontal control order	

REMARKS:

WISCONSIN
RAY P. PELISHEK
S-188
ONALASKA, WIS.
LAND SURVEYOR

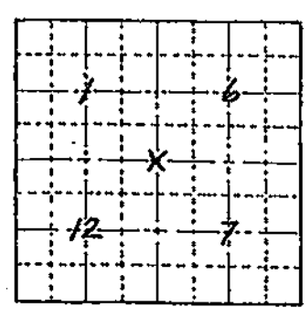

LOCATION SKETCH
(Location of landmark indicated by "x")