21707172000

U. S. PUBLIC LAND SURVEY MONUMENT RECORD

SECTION 16 T 17 N, R 7 W, TOWN OF ONALASKA

LA CROSSE COUNTY

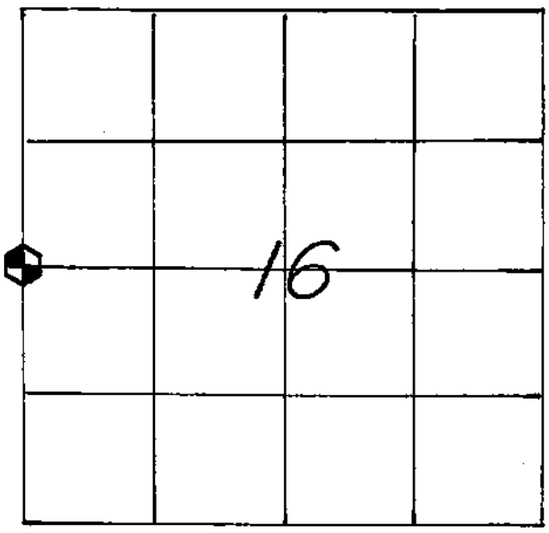

LOCATION OF LANDMARK

WISCONSIN COORDINATE SYSTEM
North
East
Theta Angle
Horiz. Order
Vert. Order
TYPE OF LANDMARK Brass cap Lunde marker.
BEARINGS ARE REFERENCED TO

Crew: WILLIAM C. JUNG
PETER F. FOLLANSBEE
Date: 5/12/1997

Describe any record evidence, monument evidence, testimonial evidence or any other material evidence you considered and whether the monument was found or restored through acceptance of an obliterated evidence location.

I set the corner at the old occupied location. Paul Fairchild and I agreed upon this location. I set a brass capped Lunde marker at the corner.

Describe or show any material discrepancy between the location of the restored corner and that of the corner previously restored or reestablished.

None Known,

RECORD OF DURABLE WITNESS MONUMENTS

NO	DESCRIPTION	BEARING (MAGNETIC)	DISTANCE
1	Set P.K. Nail in SW-side 5" Hickory	N 80°W	14.38 Ft.
2	Set P.K. Nail in SW-side 22" White Oak	Northwesterly±	2.87 Ft.
3	Set P.K. Nail in N.-side 16" Cherry	S 87°E	56.19 Ft.
4	Set P.K. Nail in NE-side 4½" Hickory	S 38°E	34.04 Ft.

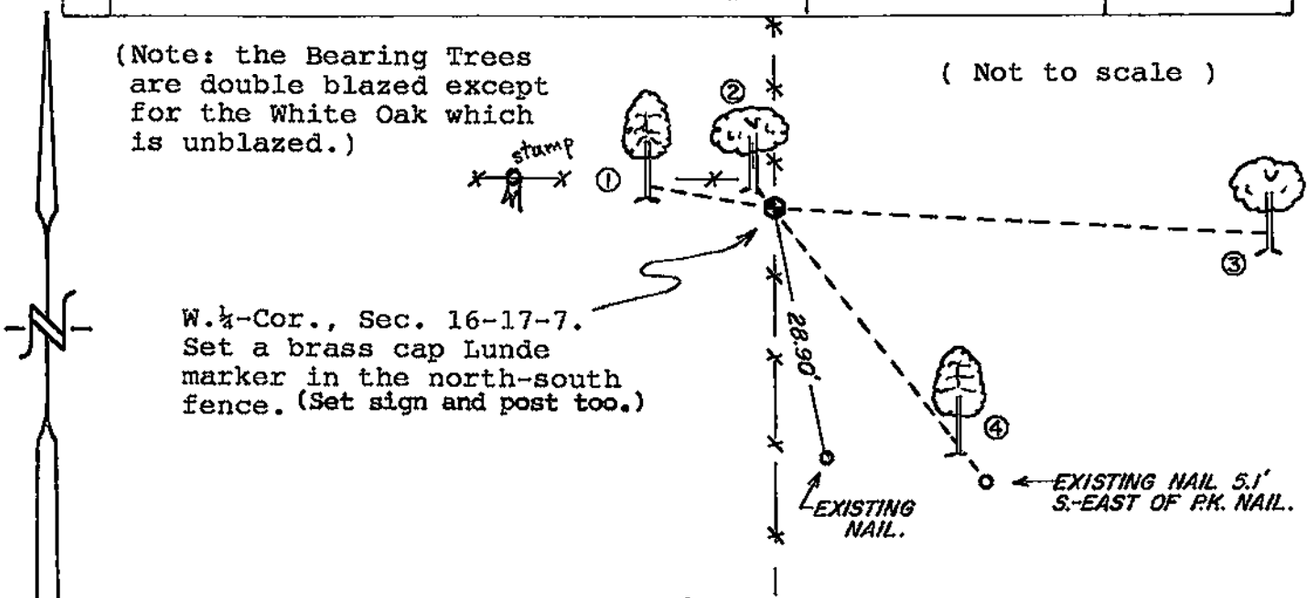

PLAN VIEW DRAWING OF REFERENCE TIES

MAP SHOWING DISTANCE AND DIRECTION TO OTHER PUBLIC LAND SURVEY CORNERS USED FOR REESTABLISHING THE CORNER

No section measurements were made by me at this time. The section measurements were made by Fairchild.

I, William C. Jung, County Surveyor
HEREBY CERTIFY THAT THE CORNER LOCATION SHOWN ON THIS RECORD WAS DETERMINED BY ME OR UNDER MY DIRECTION AND CONTROL AND THAT THIS U. S. PUBLIC LAND SURVEY MONUMENT RECORD IS CORRECT AND COMPLETE TO THE BEST OF MY KNOWLEDGE AND BELIEF.

William C. Jung — 1/12/98

Signature — Date

WISCONSIN
WILLIAM C. JUNG
S-1323
ONALASKA, WIS.
LAND SURVEYOR

Seal