NO. 89

21707180000

U. S. PUBLIC LAND SURVEY MONUMENT RECORD

SECTION 18 **T** 17 **N, R** 7 **W, TOWN OF** ONALASKA

LA CROSSE COUNTY

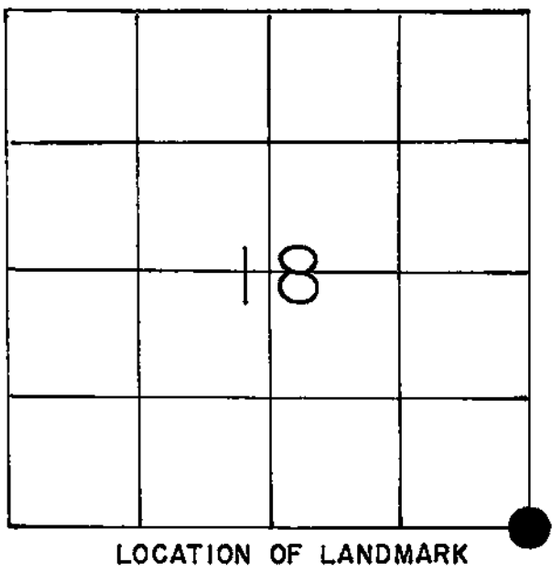

LOCATION OF LANDMARK

WISCONSIN COORDINATE SYSTEM
North
East
Theta Angle
Horiz. Order
Vert. Order
TYPE OF LANDMARK SET BRASS CAP LUNDE MARKER
BEARINGS ARE REFERENCED TO

Crew: WILLIAM C. JUNG
RON HAYDEN
PETER F. FOLLANSBEE

Date: 6/23/1988

Describe any record evidence, monument evidence, testimonial evidence or any other material evidence you considered and whether the monument was found or restored through acceptance of an obliterated evidence location.

I found an iron pipe at the occupied fence corner, removed the pipe, and replaced it with a brass capped Lunde marker. I accepted the occupied fence corner as the best available evidence of the original government corner position. The pipe had been used as the corner in previous surveys. The 1932 Corps of Engineer notes show the 4-way fence corner as the accepted corner.

Describe or show any material discrepancy between the location of the restored corner and that of the corner previously restored or reestablished.

None known.

RECORD OF DURABLE WITNESS MONUMENTS

NO	DESCRIPTION	MAGNETIC BEARING	DISTANCE
1	Set 1" x 27" I.P.(W-side of Fence Line)	N 00°E	39.41 Ft.
2	Set P.K. Nail in 5" Jack Oak (S-side)	N 87°E	24.75 Ft.
3	Set 1" x 27" I.P.(E-side of Fence Line)	S 03°E	43.41 Ft.
4	Set 1" x 27" I.P.(In Downed Fence Line)	S 87°W	59.87 Ft.

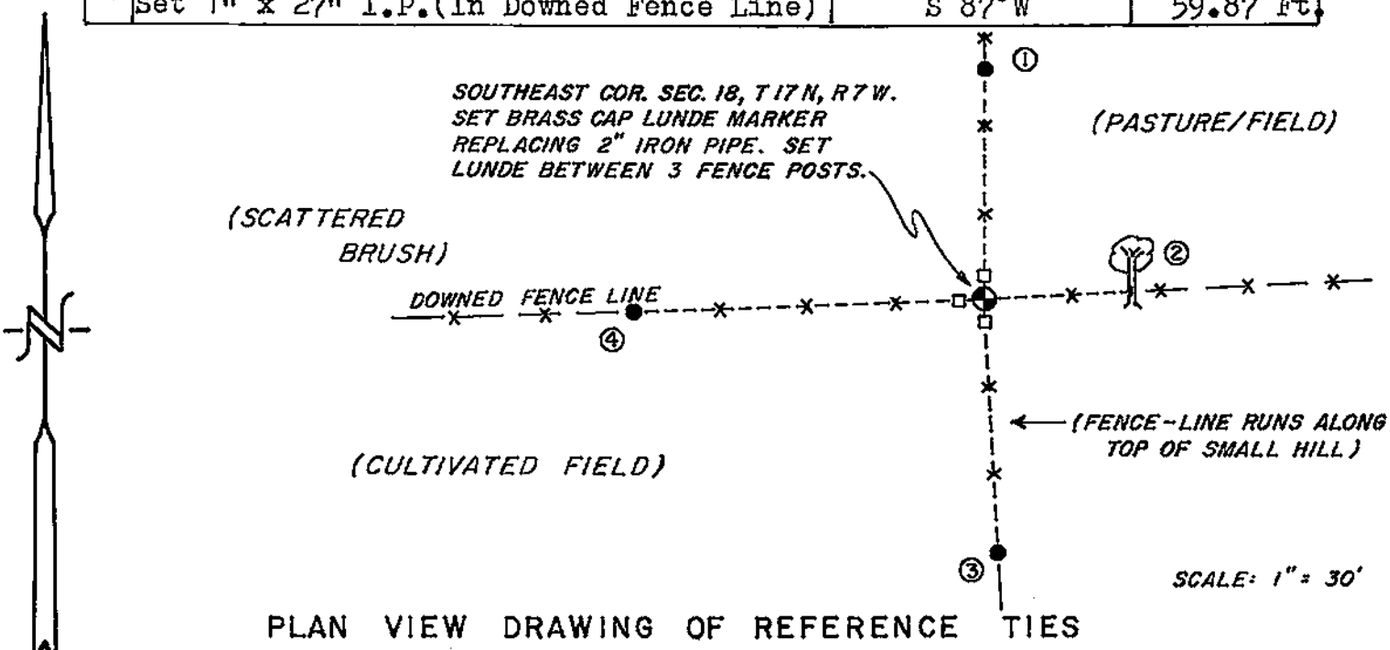

PLAN VIEW DRAWING OF REFERENCE TIES

MAP SHOWING DISTANCE AND DIRECTION TO OTHER PUBLIC LAND SURVEY CORNERS USED FOR REESTABLISHING THE CORNER

No measurements were made by me at this time, although previous measurements made by others confirm the corner location.

I, William C. Jung, Deputy County Surveyor
HEREBY CERTIFY THAT THE CORNER LOCATION SHOWN ON THIS RECORD WAS DETERMINED BY ME OR UNDER MY DIRECTION AND CONTROL AND THAT THIS U. S. PUBLIC LAND SURVEY MONUMENT RECORD IS CORRECT AND COMPLETE TO THE BEST OF MY KNOWLEDGE AND BELIEF.

William C. Jung
Signature

August 5, 1988
Date

WISCONSIN
WILLIAM C. JUNG
S-1323
ONALASKA, WIS.
LAND SURVEYOR

Seal