NO. 67

21707182020

U. S. PUBLIC LAND SURVEY MONUMENT RECORD

SECTION 18 **T** 17 **N, R** 7 **W, TOWN OF** ONALASKA

LA CROSSE COUNTY

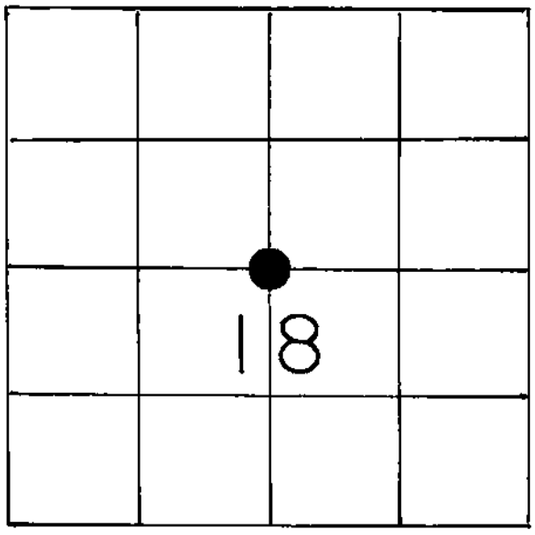

LOCATION OF LANDMARK

WISCONSIN COORDINATE SYSTEM	
North 712,726.464	(as per D.O.T.)
East 1,668,133.183	
Theta Angle	
Horiz. Order	
Vert. Order	
TYPE OF LANDMARK	
SET BRASS CAP LUNDE MARKER	
BEARINGS ARE REFERENCED TO	

Crew: WILLIAM C. JUNG
RON HAYDEN
PETER F. FOLLANSBEE

Date: 6/23/1988

Describe any record evidence, monument evidence, testimonial evidence or any other material evidence you considered and whether the monument was found or restored through acceptance of an obliterated evidence location.

I found a P.K. nail at the corner, removed the P.K. nail, and replaced it with a brass capped Lunde marker. The P.K. nail had been used as the corner in previous surveys. This location fits the occupied conditions and other evidence found in Section 18.

Describe or show any material discrepancy between the location of the restored corner and that of the corner previously restored or reestablished.

This corner is not at the intersection of the 1/4 lines. It is on line between the North and South 1/4 Corners and about 3.6 feet North of a point that would be equidistant between the North and South 1/4 Corners. I feel that this is corner was set in an irregular fashion years ago, the section was then further subdivided, and the lands occupied as such since. I feel that this old location should be accepted, for to place the Center 1/4 Corner at the intersection of the 1/4 lines now would make a shambles of the section and disrupt lines long occupied and accepted. Ron Hayden, R.L.S., also agrees with me on this point as do obviously those others surveyors who used the P.K. nail as the Center 1/4 Corner.

RECORD OF DURABLE WITNESS MONUMENTS

NO	DESCRIPTION	MAGNETIC BEARING	DISTANCE
1	Southwest corner of Single Story House	N 65°E	89.70 Ft.
2	Center of Well Top, N. of 2 Story House	S 75°E	90.20 Ft.
3	Set P.K. Nail in 20" Walnut (NW-side)	S 46°W	54.74 Ft.
4	Set P.K. Nail in 30" Burr Oak (NW-side)	S 63°W	118.50 Ft.

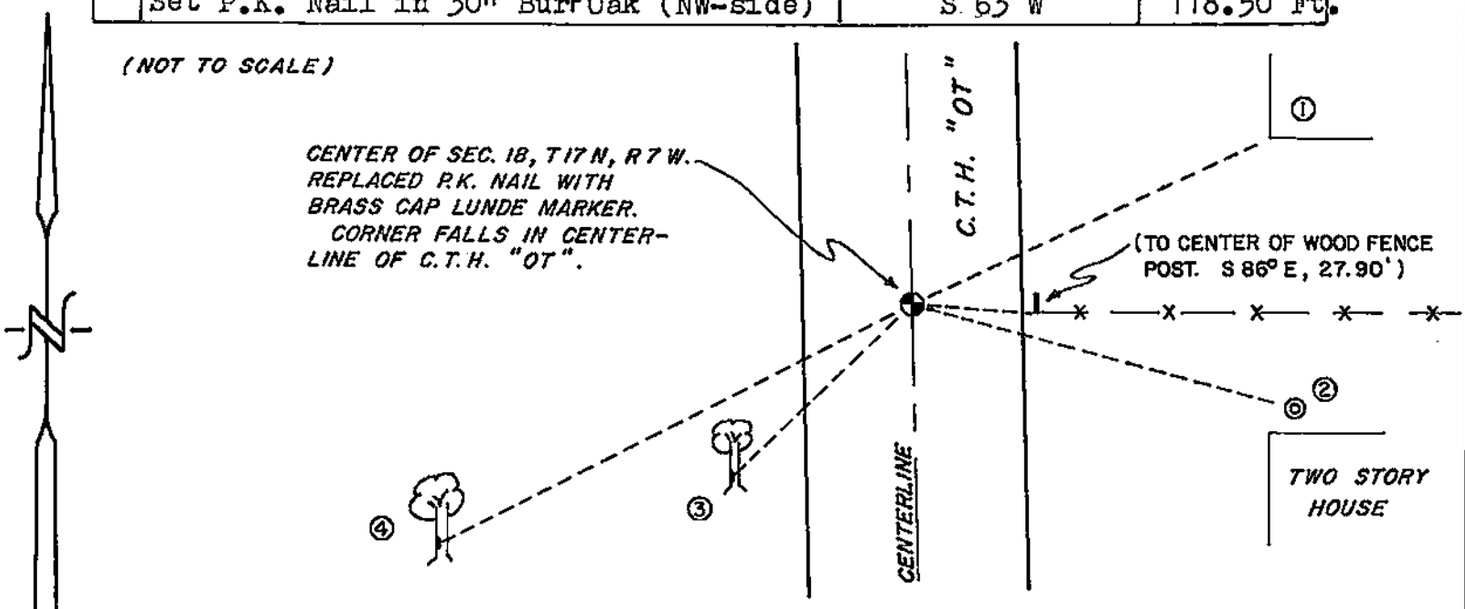

PLAN VIEW DRAWING OF REFERENCE TIES

MAP SHOWING DISTANCE AND DIRECTION TO OTHER PUBLIC LAND SURVEY CORNERS USED FOR REESTABLISHING THE CORNER

No measurements were made by me at this time, although previous measurements made by others confirm the corner location.

I, William C. Jung, Deputy County Surveyor
HEREBY CERTIFY THAT THE CORNER LOCATION SHOWN ON THIS RECORD WAS DETERMINED BY ME OR UNDER MY DIRECTION AND CONTROL AND THAT THIS U. S. PUBLIC LAND SURVEY MONUMENT RECORD IS CORRECT AND COMPLETE TO THE BEST OF MY KNOWLEDGE AND BELIEF.

William C. Jung — August 5, 1988
Signature — Date

WISCONSIN
WILLIAM C. JUNG
S-1323
ONALASKA, WIS.
LAND SURVEYOR

Seal