NO. 94

21707192000

U. S. PUBLIC LAND SURVEY MONUMENT RECORD

SECTION 20 T 17 N, R 7 W, TOWN OF Onalaska

LA CROSSE COUNTY

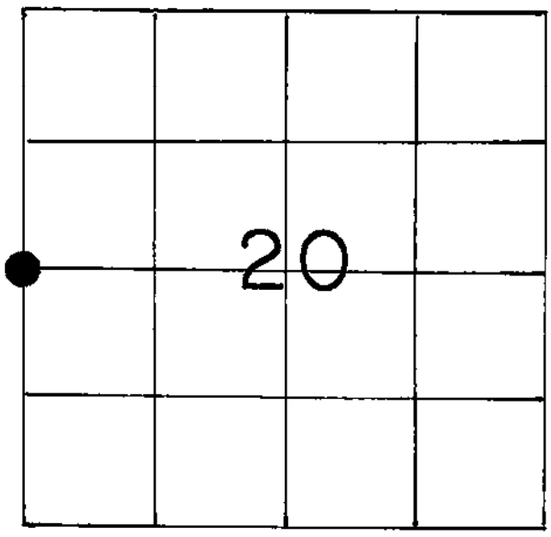

LOCATION OF LANDMARK

WISCONSIN COORDINATE SYSTEM	
North	707,443.08 (as per DOT,1927 Adj.)
East	1,670,674.52
Theta Angle	
Horiz. Order	
Vert. Order	
TYPE OF LANDMARK	Brass capped Lunde marker
BEARINGS ARE REFERENCED TO	

Crew: William C. Jung
Peter F. Follansbee

Date: October 18, 1990

Describe any record evidence, monument evidence, testimonial evidence or any other material evidence you considered and whether the monument was found or restored through acceptance of an obliterated evidence location.

I found an iron pipe at the corner that had been used in many previous surveys. This pipe was accepted as the best available evidence of the original government corner position. I removed the pipe and replaced it with a Lunde marker.

Describe or show any material discrepancy between the location of the restored corner and that of the corner previously restored or reestablished.

None known.

RECORD OF DURABLE WITNESS MONUMENTS

NO	DESCRIPTION	BEARING	DISTANCE
1	Existing 1" iron pipe	------	140.18
2	Set P.K. nail in a power pole	------	6.85
3			
4			

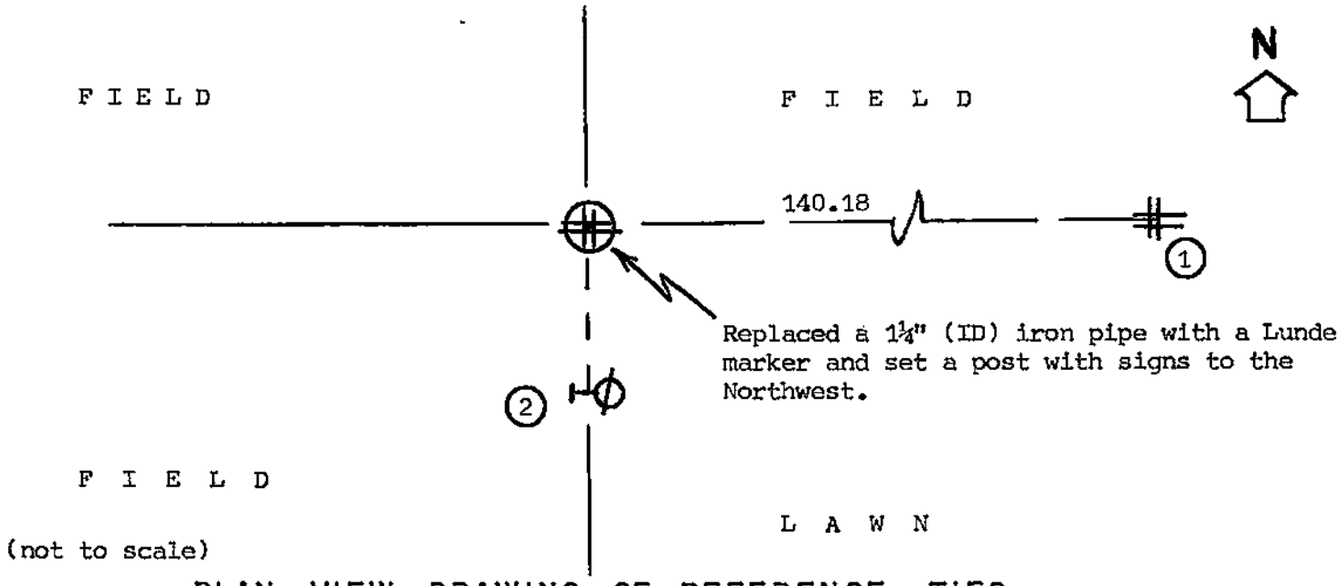

PLAN VIEW DRAWING OF REFERENCE TIES

MAP SHOWING DISTANCE AND DIRECTION TO OTHER PUBLIC LAND SURVEY CORNERS USED FOR REESTABLISHING THE CORNER

Note: No section measurements made by me at this time.

I, William C. Jung, Deputy County Surveyor,
HEREBY CERTIFY THAT THE CORNER LOCATION SHOWN ON THIS RECORD WAS DETERMINED BY ME OR UNDER MY DIRECTION AND CONTROL AND THAT THIS U. S. PUBLIC LAND SURVEY MONUMENT RECORD IS CORRECT AND COMPLETE TO THE BEST OF MY KNOWLEDGE AND BELIEF.

William C. Jung — January 14, 1991

Signature — Date

WISCONSIN WILLIAM C. JUNG S-1323 ONALASKA, WIS. LAND SURVEYOR

Seal