NO. 111

21707210000

U. S. PUBLIC LAND SURVEY MONUMENT RECORD

SECTION 27 T 17 N, R 7 W, TOWN OF ONALASKA

LA CROSSE COUNTY

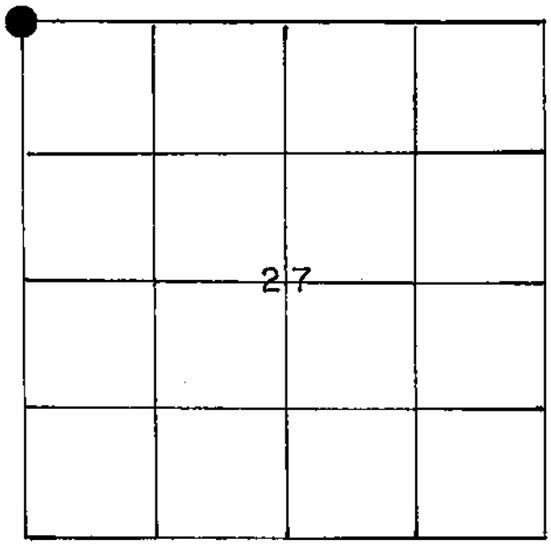

LOCATION OF LANDMARK

WISCONSIN COORDINATE SYSTEM
North
East
Theta Angle
Horiz. Order
Vert. Order
TYPE OF LANDMARK 1 3/8" iron pipe
BEARINGS ARE REFERENCED TO

Crew: William Jung
Perry Dahl
5/23/85

Describe any record evidence, monument evidence, testimonial evidence or any other material evidence you considered and whether the monument was found or restored through acceptance of an obliterated evidence location.

This iron pipe has been used as the section corner in several previous surveys, including surveys by Hurlburt, Hofmeister, Solberg, Pederson, Chalsma, and probably Murphy. I accepted the position of this corner at the occupied corner as the best available evidence of the original government corner.

Describe or show any material discrepancy between the location of the restored corner and that of the corner previously restored or reestablished.

None known.

RECORD OF DURABLE WITNESS MONUMENTS

NO	DESCRIPTION	BEARING	DISTANCE
1	P.K. nail in double blazed 9" maple	--------	42.29
2	P.K. nail in 10" double blazed boxelder	--------	65.95
3	Set 1½"x25" iron pipe	East±	28.85
4			

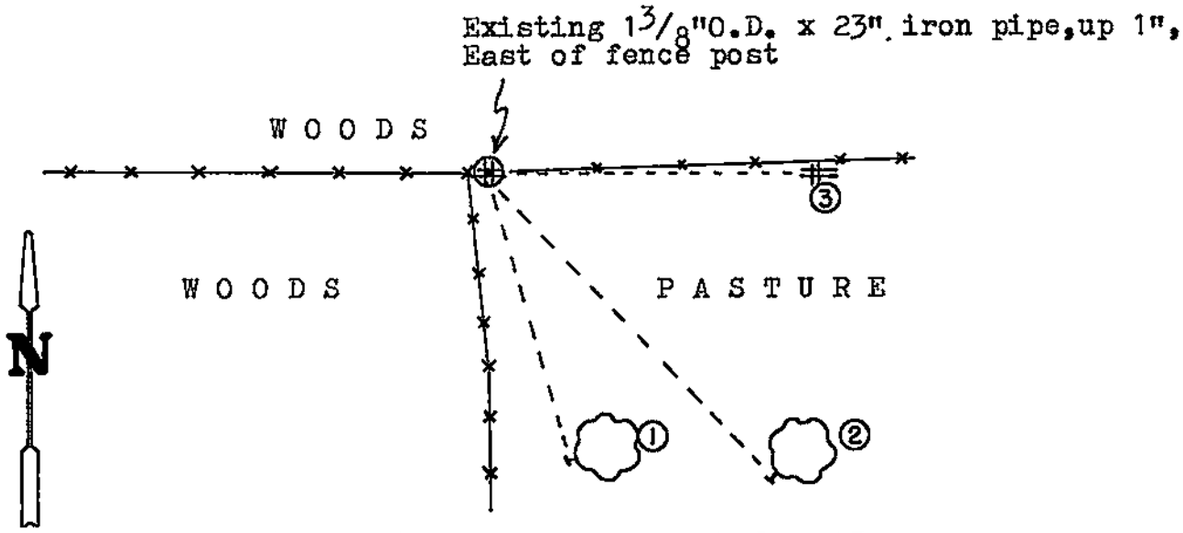

PLAN VIEW DRAWING OF REFERENCE TIES

MAP SHOWING DISTANCE AND DIRECTION TO OTHER PUBLIC LAND SURVEY CORNERS USED FOR REESTABLISHING THE CORNER

None measured by me at this time. See maps of record.

I, William C. Jung, Deputy County Surveyor,

HEREBY CERTIFY THAT THE CORNER LOCATION SHOWN ON THIS RECORD WAS DETERMINED BY ME OR UNDER MY DIRECTION AND CONTROL AND THAT THIS U. S. PUBLIC LAND SURVEY MONUMENT RECORD IS CORRECT AND COMPLETE TO THE BEST OF MY KNOWLEDGE AND BELIEF.

William C. Jung — 2/10/86

Signature — Date

Seal