21805060000

RECORD OF LAND CORNER PERPETUATION

No. _____

STATE OF WISCONSIN
County of Jackson } ss.

I, Norman R. Hurlburt, hereby certify that the information shown hereon correctly describes the original corner, resurvey information, evidence found, type of monument found or placed, and witness monuments and accessories used to perpetuate the location of the original or established corner.

Dated this 23 day of December, 1983

at Black River Falls, Wisconsin.

Norman R. Hurlburt

Registered Land Surveyor S-1104
Title

COUNTY: La Crosse		
TOWN: Farmington		
HIGHWAY: ----		
SECTION: 5	TOWNSHIP: 18N	RANGE: 5W
TYPE OF LANDMARK: 30" Berntsen Cast Aluminum Monument		

Date of Survey August 1983

Drafted by D.W. Melichar

Date Sept. 19, 1983

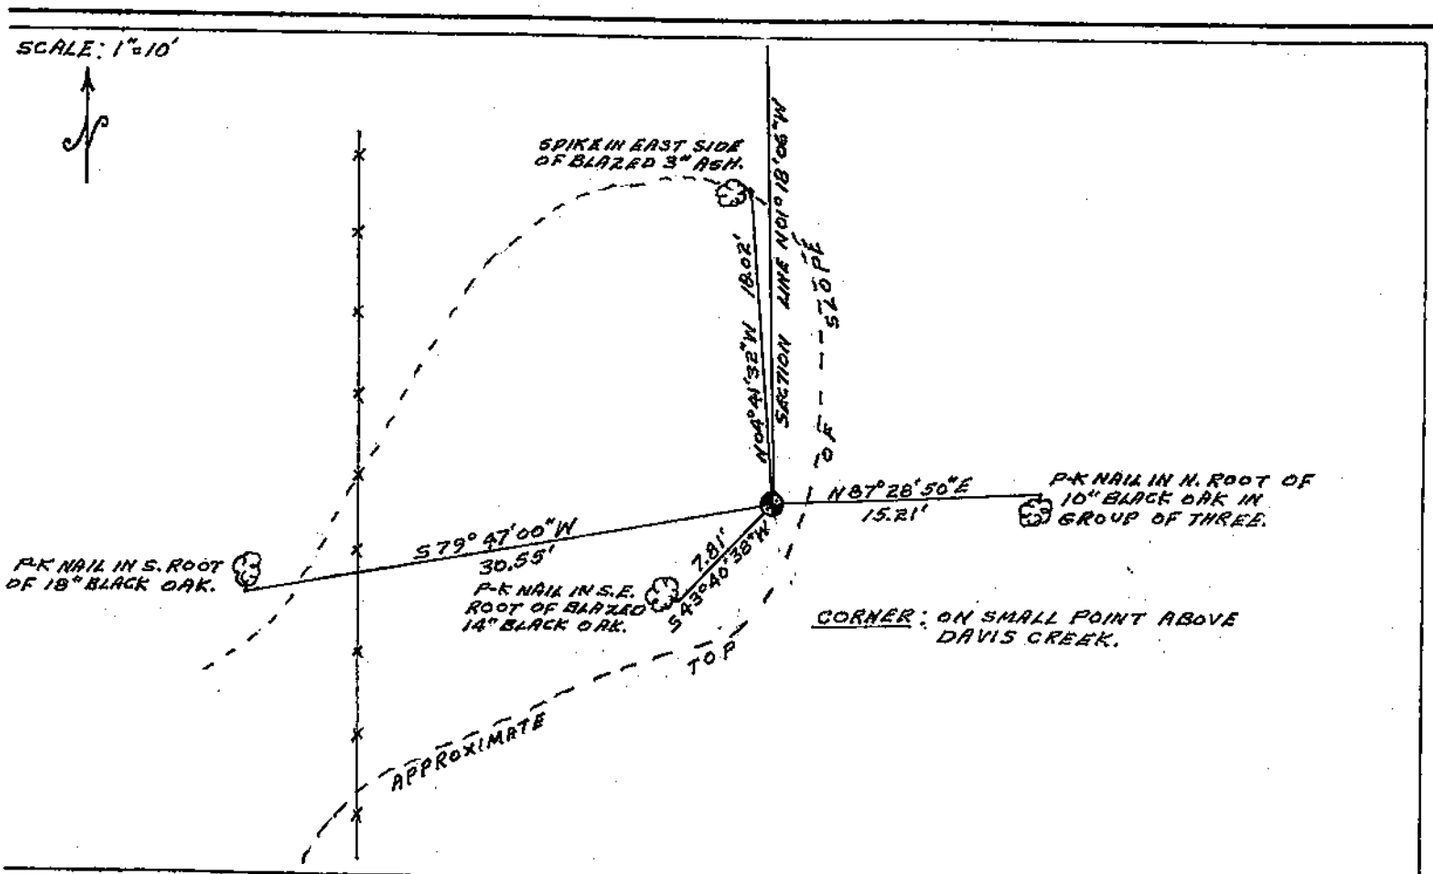

WISCONSIN COORDINATE SYSTEM	
North	Zone
East	
Elevation	Theta Angle
Vertical control order	
Horizontal control order	

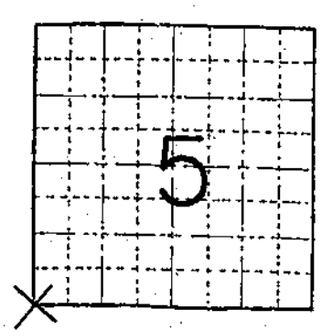

LOCATION SKETCH
(Location of landmark indicated by "x")

REMARKS: I found no evidence of the original corner or any record of remonumentation. I re-established the corner by double proportion between monumented corners ½ mile east and south, and one mile north, and the occupied corner ½ mile west. This puts the corner some 20 feet east of the fence, but the proportioned distances in all directions are within about 3 feet of government distance.