No. 76

21805142000

U. S. PUBLIC LAND SURVEY MONUMENT RECORD

SECTION 14 T 18 N, R 5 W, TOWN OF BURNS

LA CROSSE COUNTY

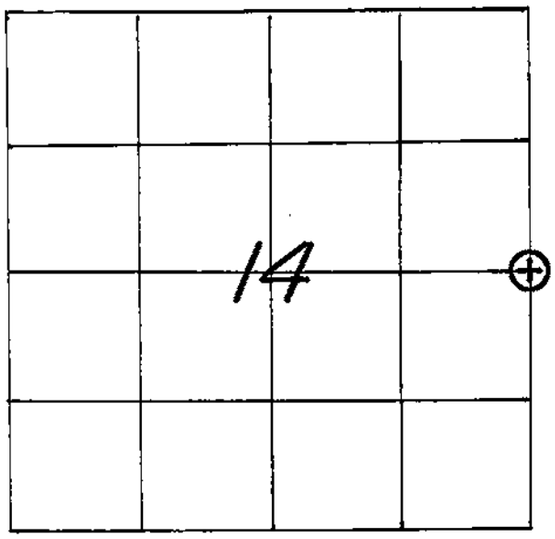

LOCATION OF LANDMARK

CREW: WILLIAM C. JUNG
PETER F. FOLLANSBEE

DATE: 10/29/2002

WISCONSIN COORDINATE SYSTEM	
North	743,379.658
East	1,723,082.378
Theta Angle	
Horiz. Order	
Vert. Order	
DATUM:	1983('91)

TYPE OF LANDMARK
3/4"x 30" IRON BAR WITH ALUMINUM CAP.

BEARINGS ARE REFERENCED TO
GRID NORTH AS PER SECTION DATA.

Describe any record evidence, monument evidence, testimonial evidence or any other material evidence you considered and whether the monument was found or restored through acceptance of an obliterated evidence location.

This corner was set "by law" at the single proportionate position. The corner was monumented with an iron bar with a Berntsen cap. The corner falls in line with an old downed four strand fence to the North and with remnants of a downed fence to the East. Oscar Liebelt told me that he was told that there never was a line fence to the West.

Describe or show any material discrepancy between the location of the restored corner and that of the corner previously restored or reestablished.

NONE KNOWN.

RECORD OF DURABLE WITNESS MONUMENTS

NO	DESCRIPTION	GRID BEARINGS BEARING	GROUND DIST.'S DISTANCE
1	SET A P.K. NAIL IN W.-SIDE OF A 13" OAK	S 13°48'02" W	38.76 FT.
2	SET A P.K. NAIL IN S.-SIDE OF A 20" OAK	N 64°22'48" W	53.12 FT.
3	SET A P.K. NAIL IN S.-SIDE OF A 19" OAK	N 51°19'34" W	68.00 FT.
4	SET A P.K. NAIL IN N.W.-SIDE OF A 19" OAK	N 87°06'26" E	58.06 FT.

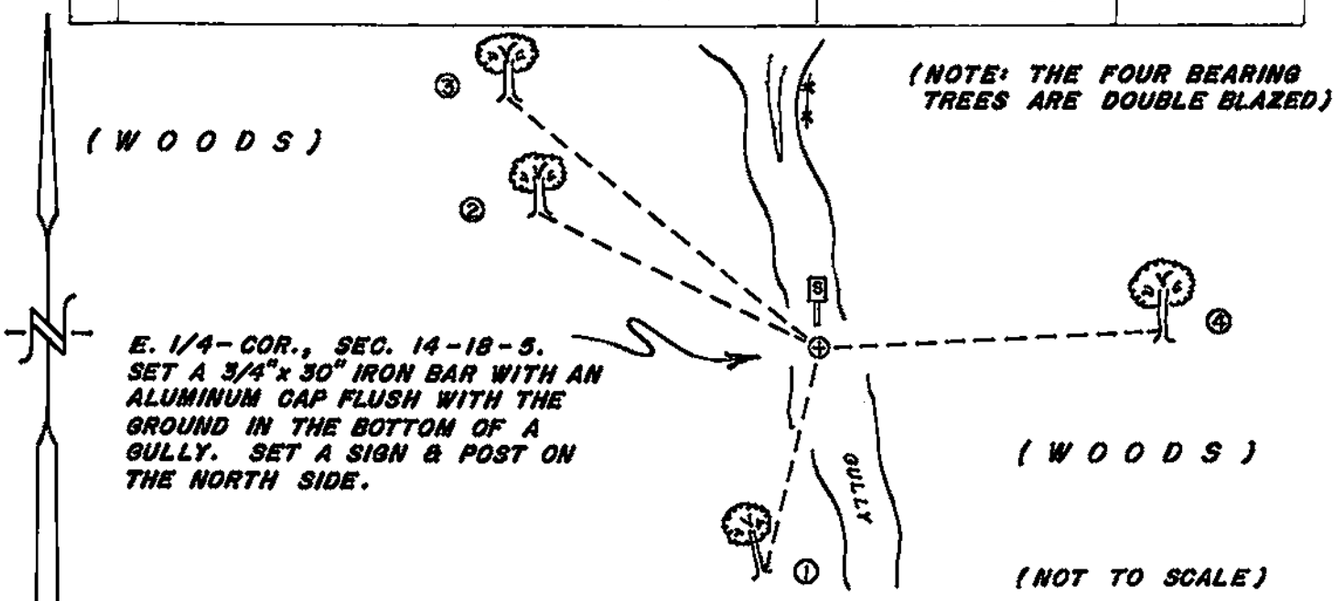

PLAN VIEW DRAWING OF REFERENCE TIES

MAP SHOWING DISTANCE AND DIRECTION TO OTHER PUBLIC LAND SURVEY CORNERS USED FOR REESTABLISHING THE CORNER

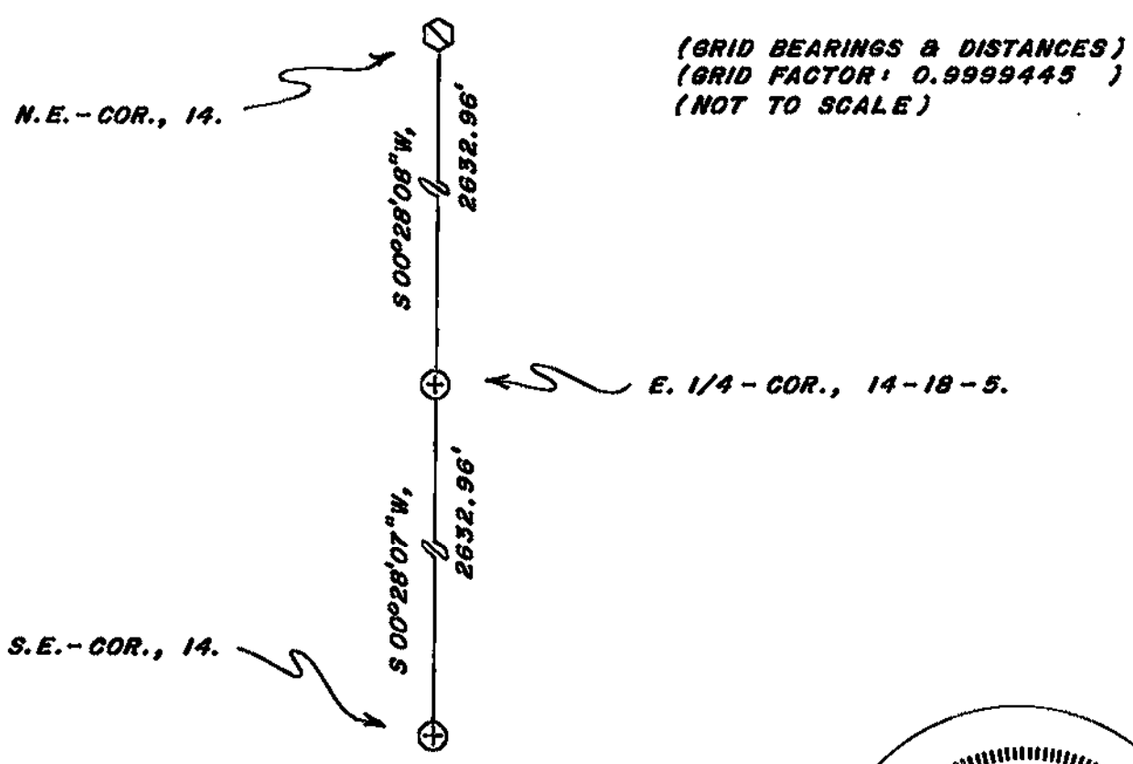

I, WILLIAM C. JUNG, COUNTY SURVEYOR

HEREBY CERTIFY THAT THE CORNER LOCATION SHOWN ON THIS RECORD WAS DETERMINED BY ME OR UNDER MY DIRECTION AND CONTROL AND THAT THIS U. S. PUBLIC LAND SURVEY MONUMENT RECORD IS CORRECT AND COMPLETE TO THE BEST OF MY KNOWLEDGE AND BELIEF.

William C. Jung 11/5/02

Signature Date

WISCONSIN WILLIAM C. JUNG S-1323 ONALASKA, WIS. LAND SURVEYOR

Seal