NO. 5

21905340000

COUNTY SURVEYOR FORM NO. 1

CERTIFICATE

I, Norman R. Hurlburt, do hereby certify that on the 29th day of April 19 83, I found (evidence) (no evidence) of the SW corner of Section 35, T 19 N, R 5W Fourth Principal Meridian, and I re-established said corner according to the Wisconsin Statutes as shown and described hereon.

Dated this 4th day of May 19 83.

Norman R. Hurlburt

Norman R. Hurlburt S-1104
Title

CERTIFIED LAND CORNER

NW-2-18-5, Burns No.

History of corner establishment since Original Government Survey

None on record

Description of corner evidence found:

Existing pipes were found at the 5¼ corner of Section 34 and the 1/16 corner east of it. The line of those pipes was projected east to intersect the line of the fence running north from here. This position fits distances north, east, and west very well, considering the steep creek banks, and is reasonably on an east-west line. The fence running west is closer to the line most of the way than it is at this corner.

Description of corner and witness monuments, references and accessories used to perpetuate the original or re-established location of this corner:

Witnesses to corner location:

N. Hurlburt

D. Melichar

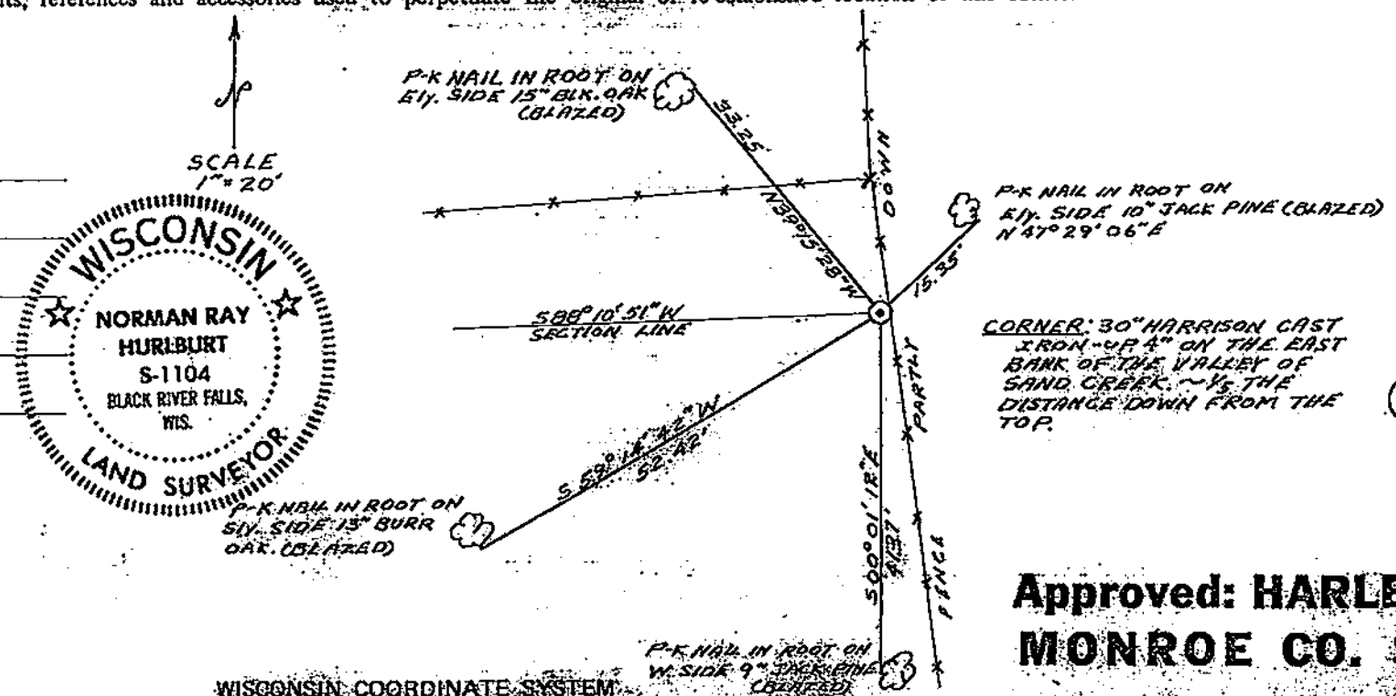


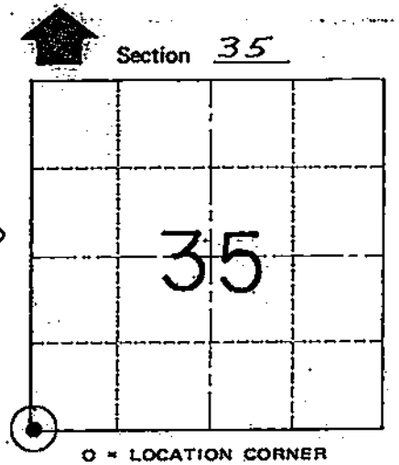


T 19 N R 5W

WISCONSIN

SURVEY CONTROL ORDER

| | |
|---|---|
| Horizontal | |
| Vertical | |

WISCONSIN COORDINATE SYSTEM

| | East (X) | North (Y) | Elevation (Z) | Zone |
|---|---|---|---|---|
| Corner | | | | |
| Control Sta. Name | | | | |

**Approved: HARLEY A. SIME**
**MONROE CO. SURVEYOR**

City, Village or Town Little Falls

County of Monroe