NO. 3

21905350000

CERTIFICATE

I, Norman R. Hurlburt, do hereby certify that on the 29th day of April 1983, I found ~~(evidence)~~ (no evidence) of the SE corner of Sec. 35, T 19 N, R 5W Fourth Principal Meridian, and I re-established said corner according to the Wisconsin Statutes as shown and described hereon.

Dated this 4th day of May 1983.

Norman R. Hurlburt

Norman R. Hurlburt S-1104
Title

CERTIFIED LAND CORNER

NW-1-18-S, Burns No.

History of corner establishment since Original Government Survey

None on Record

Approved: HARLEY A. SIME
MONROE CO. SURVEYOR

Description of corner evidence found:

This corner was set at proportional distance between the SW corner of Sec. 35 and the SE of 36. This position is about 30 feet west of the fence, but the line north falls about 15 feet east of the 1/16 corner, thus indicating a significant bend in the fence and putting its reliability in question.

COUNTY SURVEYOR FORM NO. 1

Description of corner and witness monuments, references and accessories used to perpetuate the original or re-established location of this corner:

Witnesses to corner location:

N. Hurlburt

D. Melichar

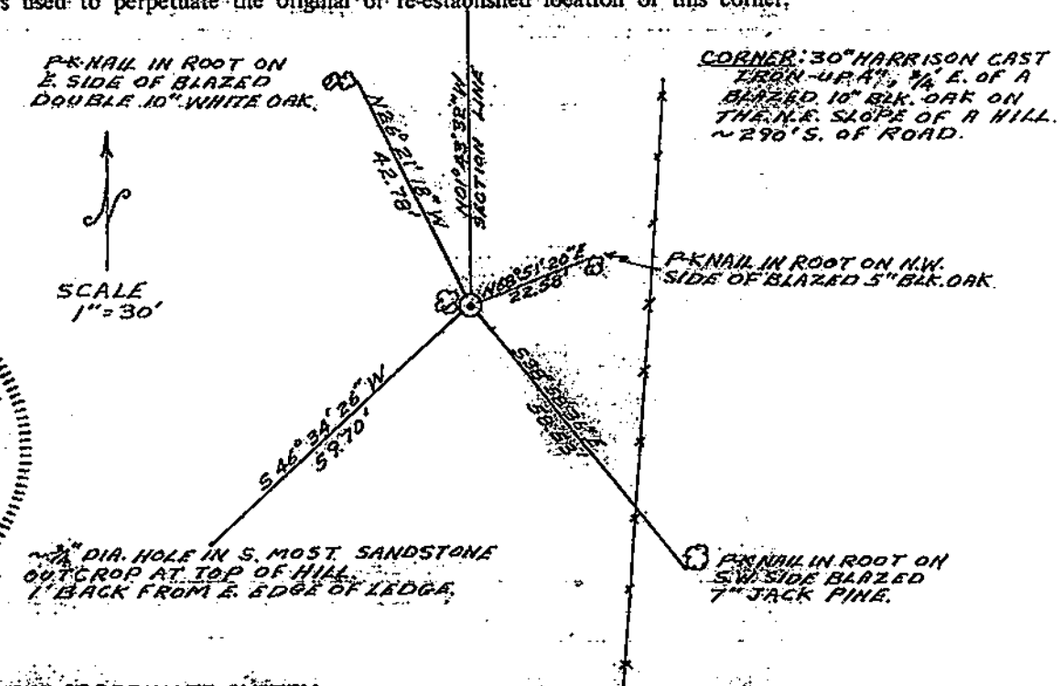

WISCONSIN
NORMAN RAY HURLBURT
S-1104
BLACK RIVER FALLS, WIS.
LAND SURVEYOR

Section 35

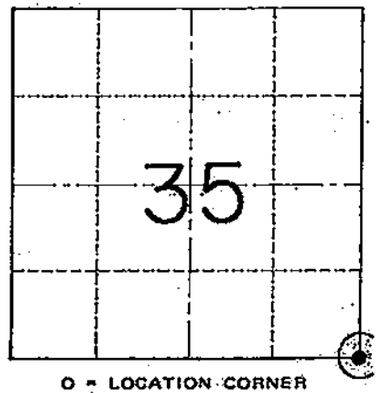

O = LOCATION CORNER

T 19 N R 5W

WISCONSIN

SURVEY CONTROL ORDER

Horizontal	
Vertical	

WISCONSIN COORDINATE SYSTEM

Corner	East (X)	North (Y)	Elevation (Z)	Zone
Control Sta. Name				

~~City~~ Village or Town Little Falls

County of Monroe