NO. 44

21806082000

U. S. PUBLIC LAND SURVEY MONUMENT RECORD

SECTION 9 T 18 N, R 6 W, TOWN OF FARMINGTON

LA CROSSE COUNTY

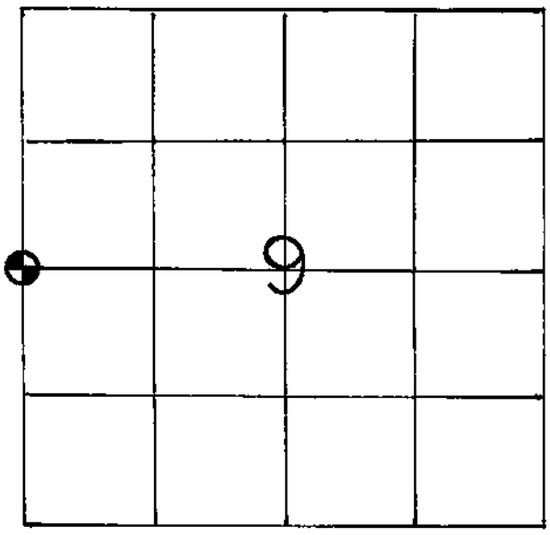

LOCATION OF LANDMARK

WISCONSIN COORDINATE SYSTEM
North
East
Theta Angle
Horiz. Order
Vert. Order
TYPE OF LANDMARK 3" IRON PIPE
BEARINGS ARE REFERENCED TO

CREW: BILL JUNG
PERRY DAHL
DATE: 10-24-85

Describe any record evidence, monument evidence, testimonial evidence or any other material evidence you considered and whether the monument was found or restored through acceptance of an obliterated evidence location.

In October of 1985 Norm Hurlburt surveyed out Section 9 and determined the computed location of this corner. I set the corner at Norm's computed location and monumented it with a 3" pipe. In my opinion this computed location fits the field evidence very well.

Describe or show any material discrepancy between the location of the restored corner and that of the corner previously restored or reestablished.

None known.

RECORD OF DURABLE WITNESS MONUMENTS

NO	DESCRIPTION	MAGNETIC BEARING	DISTANCE
1	P.K. NAIL IN DOUBLE BLAZED 8" OAK TREE	N34°E	SLOPE 20'
2	P.K. NAIL IN DOUBLE BLAZED 15" OAK TREE	N2°W	9.94'
3	P.K. NAIL IN DOUBLE BLAZED 12" OAK TREE	N27°W	19.74'
4	P.K. NAIL IN DOUBLE BLAZED 6" OAK TREE	N75°E	4.16'

(Each P.K. nail is in a hack on the side of the tree.)

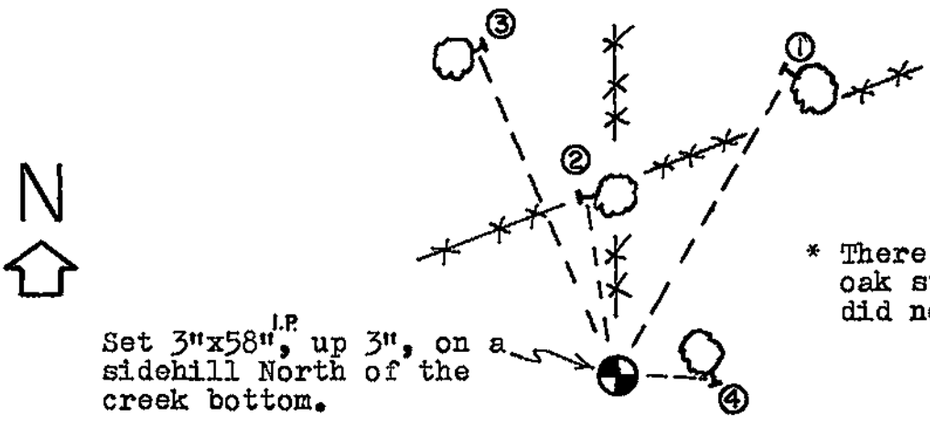

* There is a large old black oak stump to the NE that Norm did not feel was an original.

PLAN VIEW DRAWING OF REFERENCE TIES

MAP SHOWING DISTANCE AND DIRECTION TO OTHER PUBLIC LAND SURVEY CORNERS USED FOR REESTABLISHING THE CORNER

None measured by me at this time. See Hurlburt's map, dated 11/13/85.

I, William C. Jung, Deputy County Surveyor, HEREBY CERTIFY THAT THE CORNER LOCATION SHOWN ON THIS RECORD WAS DETERMINED BY ME OR UNDER MY DIRECTION AND CONTROL AND THAT THIS U. S. PUBLIC LAND SURVEY MONUMENT RECORD IS CORRECT AND COMPLETE TO THE BEST OF MY KNOWLEDGE AND BELIEF.

William C. Jung — 2/7/86

Signature — Date

WISCONSIN WILLIAM C. JUNG S-1323 ONALASKA, WIS. LAND SURVEYOR

Seal