21807032000

U. S. PUBLIC LAND SURVEY MONUMENT RECORD

SECTION 3 T 18 N, R 7 W, TOWN OF FARMINGTON

LA CROSSE COUNTY

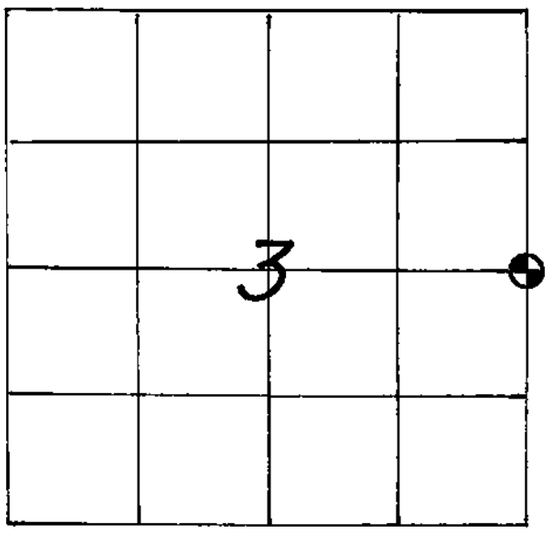

LOCATION OF LANDMARK

WISCONSIN COORDINATE SYSTEM
North
East
Theta Angle
Horiz. Order
Vert. Order
TYPE OF LANDMARK
1¼" x 30" I.B. in 1-5/8" x 30" I.P.
BEARINGS ARE REFERENCED TO

Crew: WILLIAM C. JUNG
PETER F. FOLLANSBEE
Date: 11/15/1995

Describe any record evidence, monument evidence, testimonial evidence or any other material evidence you considered and whether the monument was found or restored through acceptance of an obliterated evidence location.

The corner was set at a computed location as determined by Norm Hurlburt in 1990. See Hurlburt's "Map of Survey", dated Jan. 3, 1991, for more detail.

Describe or show any material discrepancy between the location of the restored corner and that of the corner previously restored or reestablished.

None Known.

RECORD OF DURABLE WITNESS MONUMENTS

NO	DESCRIPTION	MAGNETIC BEARING	DISTANCE
1	Set P.K. Nail in NE-side 6" White Pine	N 32° W	25.47 Ft.
2	Set P.K. Nail in W.-side 5¼" White Oak	N 01° E	23.01 Ft.
3	Set P.K. Nail in SW-side 13" Burr Oak	S 70° E	19.98 Ft.
4	Set P.K. Nail in E.-side 8" Oak	S 01° E	13.73 Ft.

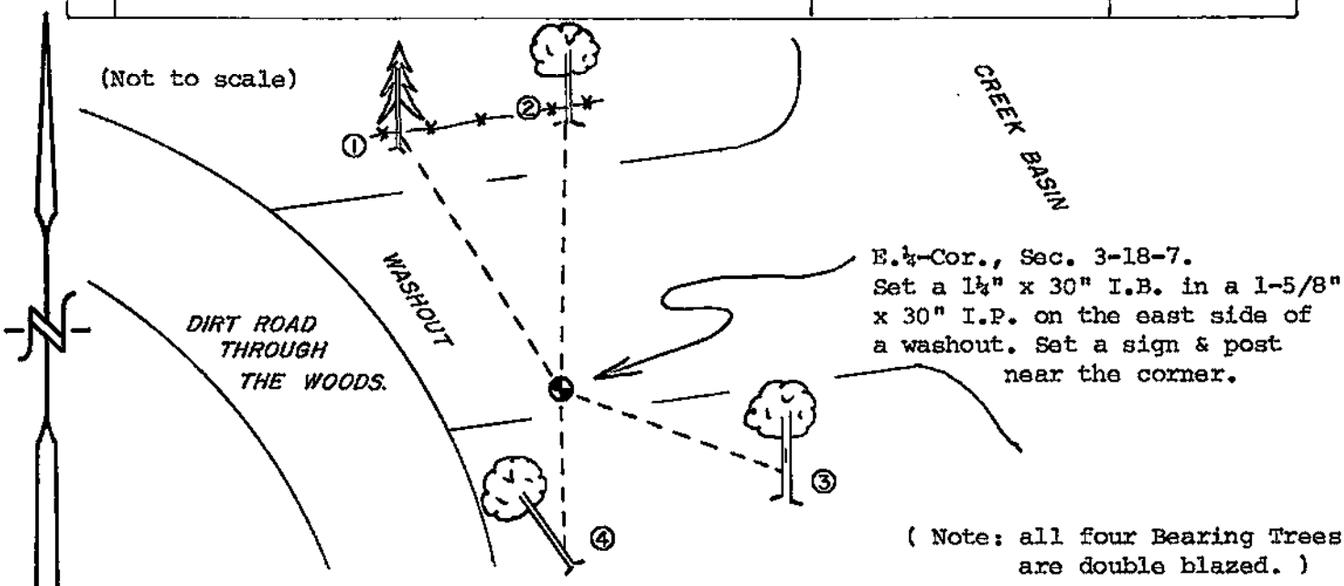

PLAN VIEW DRAWING OF REFERENCE TIES

MAP SHOWING DISTANCE AND DIRECTION TO OTHER PUBLIC LAND SURVEY CORNERS USED FOR REESTABLISHING THE CORNER

No section measurements were made by me at this time. See section data of record.

I, William C. Jung, County Surveyor
HEREBY CERTIFY THAT THE CORNER LOCATION SHOWN ON THIS RECORD WAS DETERMINED BY ME OR UNDER MY DIRECTION AND CONTROL AND THAT THIS U. S. PUBLIC LAND SURVEY MONUMENT RECORD IS CORRECT AND COMPLETE TO THE BEST OF MY KNOWLEDGE AND BELIEF.

William C. Jung — 12/29/95

Signature — Date

WISCONSIN WILLIAM C. JUNG S-1323 ONALASKA, WIS. LAND SURVEYOR

Seal