21807150020

U. S. PUBLIC LAND SURVEY MONUMENT RECORD

SECTION *15* T *18* N, R *7* W, TOWN OF *FARMINGTON*

LA CROSSE COUNTY

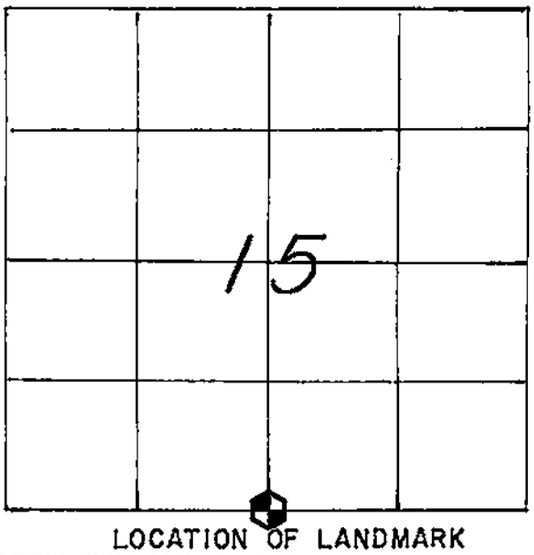

LOCATION OF LANDMARK

CREW: WILLIAM C. JUNG
PETER F. FOLLANSBEE
DATE: 9/02/1997

WISCONSIN COORDINATE SYSTEM
North
East
Theta Angle
Horiz. Order
Vert. Order
TYPE OF LANDMARK *BRASS CAP LUNDE MARKER.*
BEARINGS ARE REFERENCED TO

Describe any record evidence, monument evidence, testimonial evidence or any other material evidence you considered and whether the monument was found or restored through acceptance of an obliterated evidence location.

I found an iron bar at the corner which had been used as the corner in several previous surveys. I accepted this location as the best available evidence of the original government corner position. The iron bar was removed and replaced with a brass capped Lunde marker.

Describe or show any material discrepancy between the location of the restored corner and that of the corner previously restored or reestablished.

NONE KNOWN.

RECORD OF DURABLE WITNESS MONUMENTS

NO	DESCRIPTION	MAGNETIC BEARING	DISTANCE
1	SET A NAIL IN S.W.-SIDE 11-1/2" ASPEN (DOUBLE BLAZED)	N 28° W	59.65 FT.
2	EXISTING 1-1/4" IRON PIPE	N 01° W	41.08 FT.
3	SET 5/8" x 17-1/2" REBAR 3' S. OF ANGLE IRON POST	N 48° E	47.21 FT.
4	SET A NAIL IN N.-SIDE 15-1/2" COTTONWOOD (UNBLAZED)	EAST ±	74.12 FT.

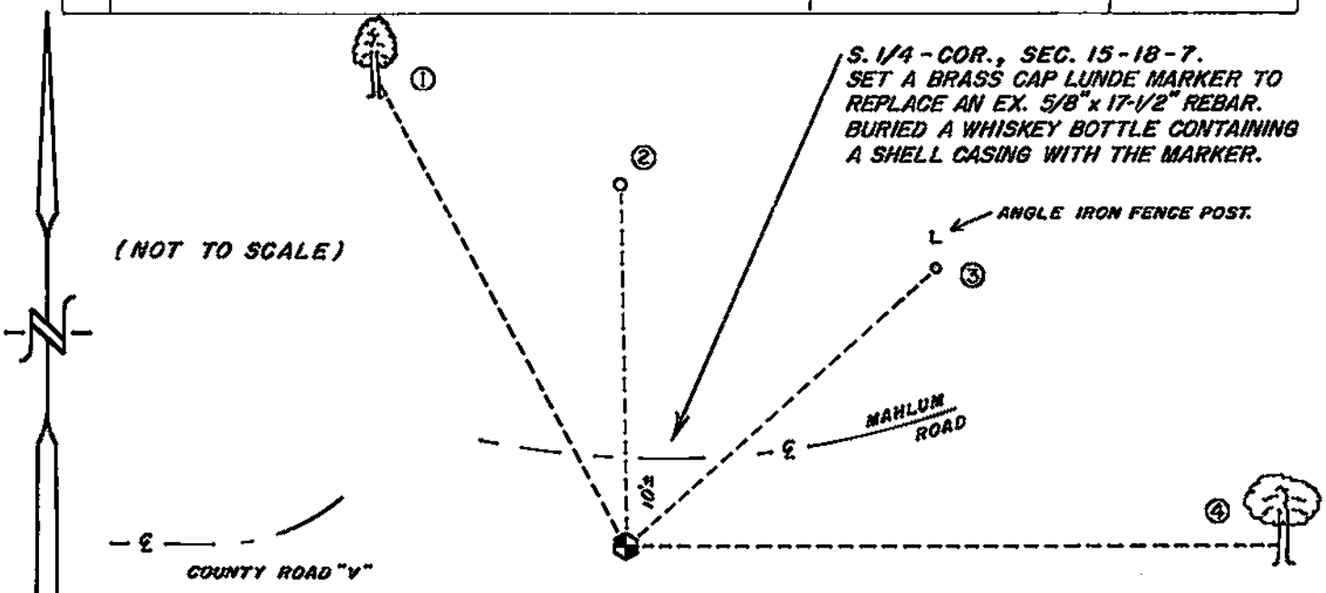

PLAN VIEW DRAWING OF REFERENCE TIES

MAP SHOWING DISTANCE AND DIRECTION TO OTHER PUBLIC LAND SURVEY CORNERS USED FOR REESTABLISHING THE CORNER

No section measurements were made by me at this time. The location of this corner was confirmed through previous section work.

I, WILLIAM C. JUNG, COUNTY SURVEYOR
HEREBY CERTIFY THAT THE CORNER LOCATION SHOWN ON THIS RECORD WAS DETERMINED BY ME OR UNDER MY DIRECTION AND CONTROL AND THAT THIS U. S. PUBLIC LAND SURVEY MONUMENT RECORD IS CORRECT AND COMPLETE TO THE BEST OF MY KNOWLEDGE AND BELIEF.

William C. Jung — 1/13/98

Signature — Date

WISCONSIN WILLIAM C. JUNG S-1323 ONALASKA, WIS. LAND SURVEYOR

Seal