No. 86

21807160020

U. S. PUBLIC LAND SURVEY MONUMENT RECORD

SECTION 21 T 18 N, R 7 W, TOWN OF HOLLAND

LA CROSSE COUNTY

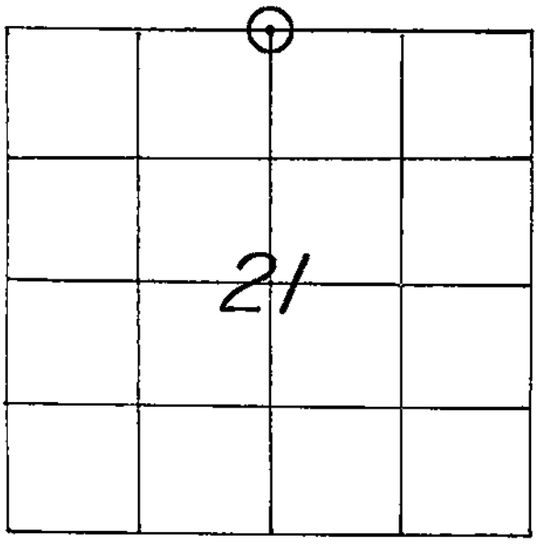

LOCATION OF LANDMARK

CREW: WILLIAM C. JUNG
PETER F. FOLLANSBEE

DATE: 2/19/2004

WISCONSIN COORDINATE SYSTEM
North
East
Theta Angle
Horiz. Order
Vert. Order

TYPE OF LANDMARK

1-1/4" (O.D.) IRON PIPE WITH A PLASTIC PLUG.

BEARINGS ARE REFERENCED TO

Describe any record evidence, monument evidence, testimonial evidence or any other material evidence you considered and whether the monument was found or restored through acceptance of an obliterated evidence location.

We found a pipe at the old occupied fence corner that had been used as the corner in previous survey work of record. I accepted this location as the best available evidence of the original government corner position. We tied off the pipe.

Describe or show any material discrepancy between the location of the restored corner and that of the corner previously restored or reestablished.

NONE KNOWN.

RECORD OF DURABLE WITNESS MONUMENTS

NO	DESCRIPTION	MAGNETIC BEARING	DISTANCE
1	SET A NAIL IN W.-SIDE OF A 4-1/2" HICKORY	N 11° W	33.04 FT.
2	SET A NAIL IN W.-SIDE OF A 3" HICKORY	N 03° E	31.12 FT.
3	SET A NAIL IN N.W.-SIDE OF A 5-1/2" HICKORY	N 17° E	33.69 FT.
4	SET A NAIL IN N.W.-SIDE OF AN 8" OAK	N 40° E	34.05 FT.

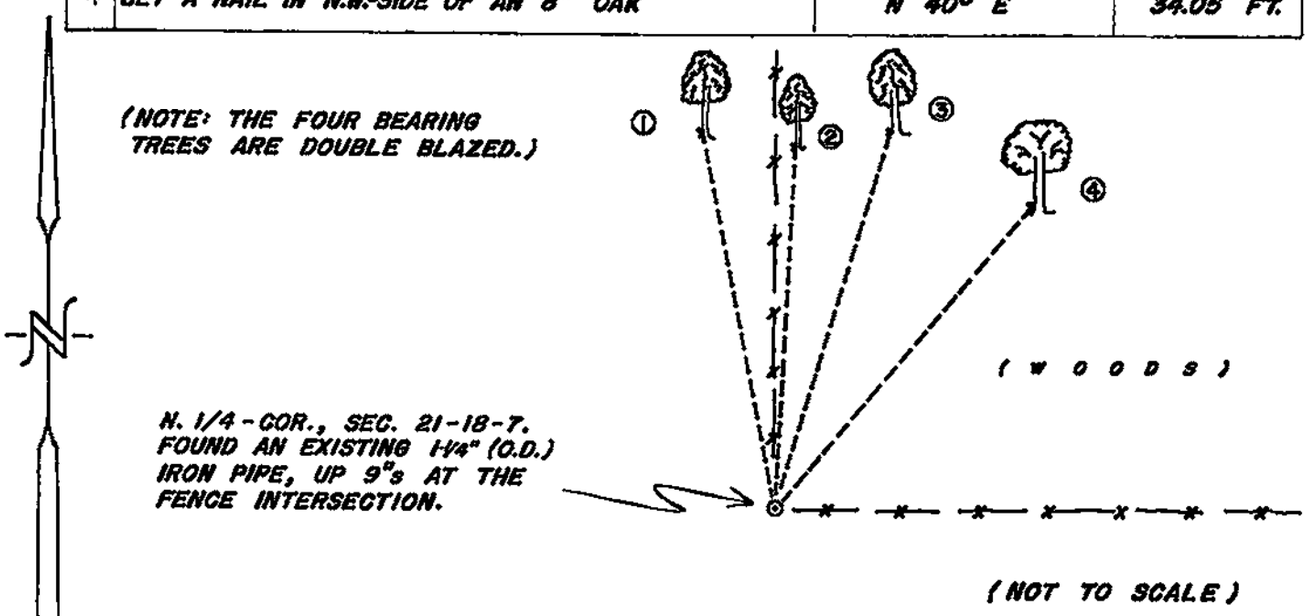

PLAN VIEW DRAWING OF REFERENCE TIES

MAP SHOWING DISTANCE AND DIRECTION TO OTHER PUBLIC LAND SURVEY CORNERS USED FOR REESTABLISHING THE CORNER

No further section measurements were made by me at this time. Previous survey work and measurements of record confirmed the location of this corner.

I, WILLIAM C. JUNG, COUNTY SURVEYOR
HEREBY CERTIFY THAT THE CORNER LOCATION SHOWN ON THIS RECORD WAS DETERMINED BY ME OR UNDER MY DIRECTION AND CONTROL AND THAT THIS U. S. PUBLIC LAND SURVEY MONUMENT RECORD IS CORRECT AND COMPLETE TO THE BEST OF MY KNOWLEDGE AND BELIEF.

William C. Jung — 2/16/05

Signature — Date

WISCONSIN
WILLIAM C. JUNG
S-1323
ONALASKA, WIS.
LAND SURVEYOR

Seal