NO. 96

21807202000

U. S. PUBLIC LAND SURVEY MONUMENT RECORD

SECTION 20 **T** 18 **N,** **R** 7 **W,** **TOWN OF** Holland

LA CROSSE COUNTY

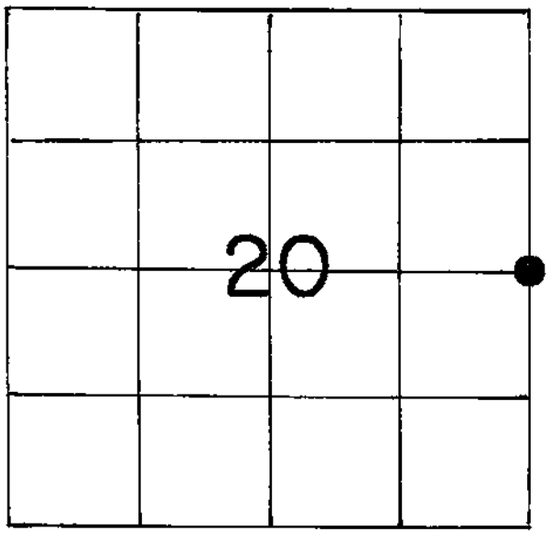

LOCATION OF LANDMARK

WISCONSIN COORDINATE SYSTEM
North
East
Theta Angle
Horiz. Order
Vert. Order
TYPE OF LANDMARK 2½" iron pipe
BEARINGS ARE REFERENCED TO

Crew: William C. Jung
Peter Follansbee

Date: 12/21/88

Describe any record evidence, monument evidence, testimonial evidence or any other material evidence you considered and whether the monument was found or restored through acceptance of an obliterated evidence location.

Robert Chalsma set an iron pipe at the old occupied corner post and accepted it as the best available evidence of the original government corner position. This has since been used as the corner in other surveys.

Describe or show any material discrepancy between the location of the restored corner and that of the corner previously restored or reestablished.

None known at this time.

RECORD OF DURABLE WITNESS MONUMENTS

NO	DESCRIPTION	Magnetic BEARING	Slope DISTANCE
1	P.K. in double blazed 8" hickory	S8°W	16.92
2	" " " " 6" "	N30°W	28.40
3	" " " " 4" "	N64°E	18.35
4	" " " " 8" "	S80°E	18.41

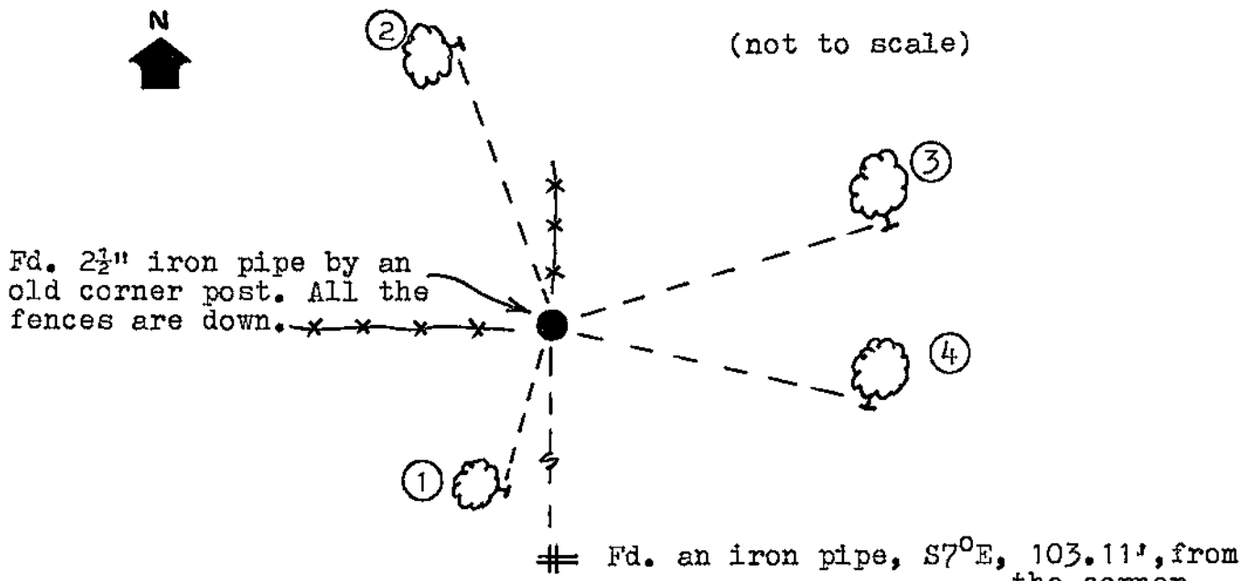

PLAN VIEW DRAWING OF REFERENCE TIES

MAP SHOWING DISTANCE AND DIRECTION TO OTHER PUBLIC LAND SURVEY CORNERS USED FOR REESTABLISHING THE CORNER

(no measurements made by me at this time)

I, William C. Jung, Deputy County Surveyor, HEREBY CERTIFY THAT THE CORNER LOCATION SHOWN ON THIS RECORD WAS DETERMINED BY ME OR UNDER MY DIRECTION AND CONTROL AND THAT THIS U. S. PUBLIC LAND SURVEY MONUMENT RECORD IS CORRECT AND COMPLETE TO THE BEST OF MY KNOWLEDGE AND BELIEF.

William C. Jung
Signature

1/13/89
Date

WISCONSIN
WILLIAM C. JUNG
S-1323
ONALASKA, WIS.
LAND SURVEYOR

Seal