NO. 111

21807210000

U. S. PUBLIC LAND SURVEY MONUMENT RECORD

SECTION 22 T 18 N, R 7 W, TOWN OF Farmington

LA CROSSE COUNTY

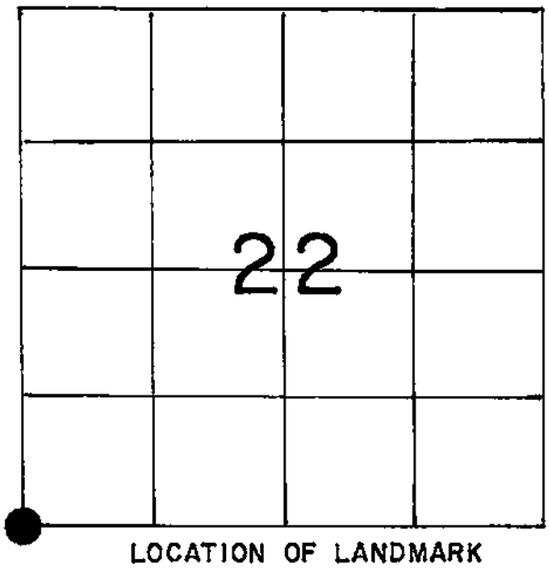

LOCATION OF LANDMARK

WISCONSIN COORDINATE SYSTEM
North
East
Theta Angle
Horiz. Order
Vert. Order

TYPE OF LANDMARK
Brass capped Lunde marker

BEARINGS ARE REFERENCED TO

Crew: William C. Jung
Peter Follansbee

Date: 9/21/88

Describe any record evidence, monument evidence, testimonial evidence or any other material evidence you considered and whether the monument was found or restored through acceptance of an obliterated evidence location.

I found a spike at the corner that had been used as the corner in previous surveys. I removed the spike and replaced it with a brass capped Lunde marker, flush. As a memorial, I buried a whiskey bottle with a blank bullet on the Southeast side of the marker.

Describe or show any material discrepancy between the location of the restored corner and that of the corner previously restored or reestablished.

None known.

RECORD OF DURABLE WITNESS MONUMENTS

NO	DESCRIPTION	BEARING (Magnetic)	DISTANCE
1	Set 1" iron pipe	S1°E	36.20
2	P.K. nail in double blazed 7" poplar	S14°W	38.88
3	P.K. nail in 11" unblazed walnut	N24°W	44.48
4	Set 1" iron pipe	N88°E	19.05

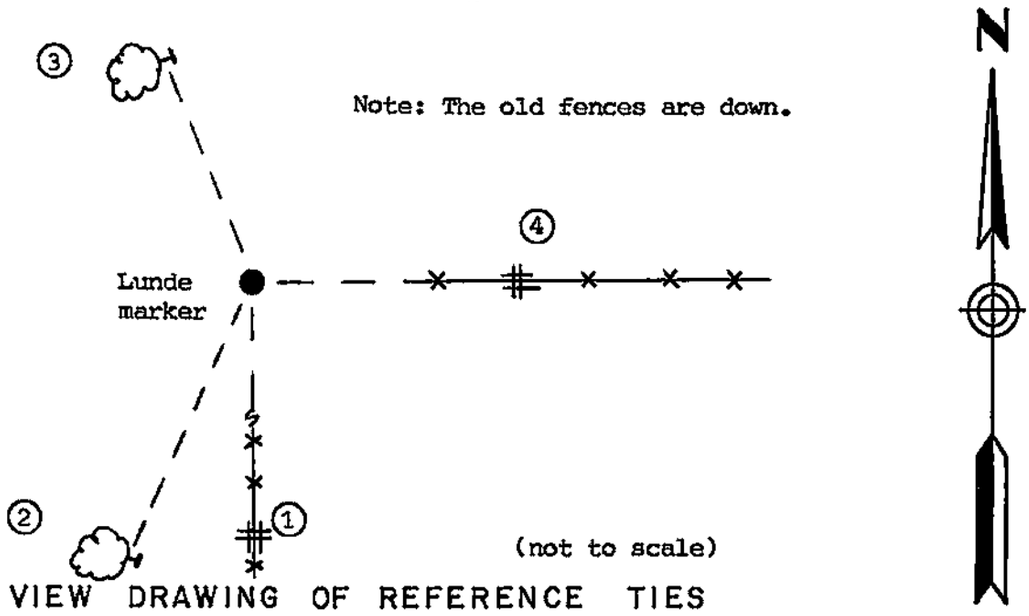

PLAN VIEW DRAWING OF REFERENCE TIES

MAP SHOWING DISTANCE AND DIRECTION TO OTHER PUBLIC LAND SURVEY CORNERS USED FOR REESTABLISHING THE CORNER

(No section measurements were made by me at this time. The section was "run out" by Norm Hurlburt.)

I, William C. Jung, Deputy County Surveyor,
HEREBY CERTIFY THAT THE CORNER LOCATION SHOWN ON THIS RECORD WAS DETERMINED BY ME OR UNDER MY DIRECTION AND CONTROL AND THAT THIS U. S. PUBLIC LAND SURVEY MONUMENT RECORD IS CORRECT AND COMPLETE TO THE BEST OF MY KNOWLEDGE AND BELIEF.

William C. Jung — 1/19/89

Signature — Date

WISCONSIN
WILLIAM C. JUNG
S-1323
ONALASKA, WIS.
LAND SURVEYOR

Seal