NO. 98

21807212000

U. S. PUBLIC LAND SURVEY MONUMENT RECORD

SECTION 22 T 18 N, R 7 W, TOWN OF Farmington

LA CROSSE COUNTY

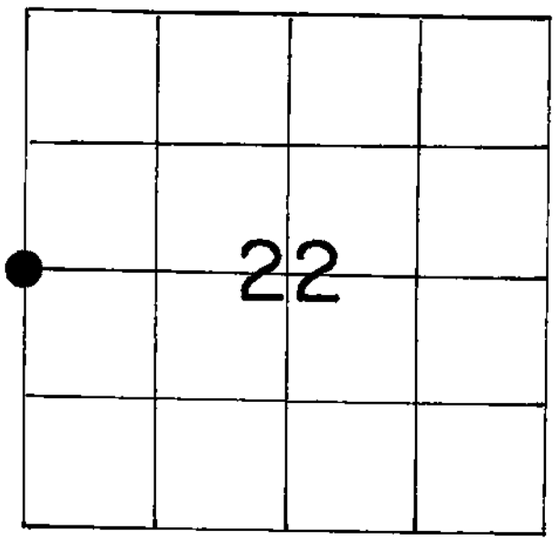

LOCATION OF LANDMARK

WISCONSIN COORDINATE SYSTEM
North
East
Theta Angle
Horiz. Order
Vert. Order
TYPE OF LANDMARK P.K. nail over Brass capped Lunde marker
BEARINGS ARE REFERENCED TO

Crew: William C. Jung
Peter Follansbee

Date: 9/23/88

Crew: William C. Jung
Peter F. Follansbee

Date: 6/8/94

Describe any record evidence, monument evidence, testimonial evidence or any other material evidence you considered and whether the monument was found or restored through acceptance of an obliterated evidence location.

I found a railroad spike at the corner. This point has been used as the corner in previous survey work. I accepted this location as the best available evidence of the original government corner position. I removed the railroad spike and replaced it with a brass capped Lunde marker.

The road was repaved so I set a P.K. nail over the Lunde marker.

Describe or show any material discrepancy between the location of the restored corner and that of the corner previously restored or reestablished.

None known.

RECORD OF DURABLE WITNESS MONUMENTS

NO	DESCRIPTION	BEARING	DISTANCE
1	Existing railroad spike	South ±	42.04
2	To the center of the telephone box @ base	-----	19.09 ~~19.14~~
3	~~Set~~ 1" iron pipe, ~~flush~~ buried Existing	West ±	29.00
4	Existing 1½" iron pipe, flush	East ±	37.00

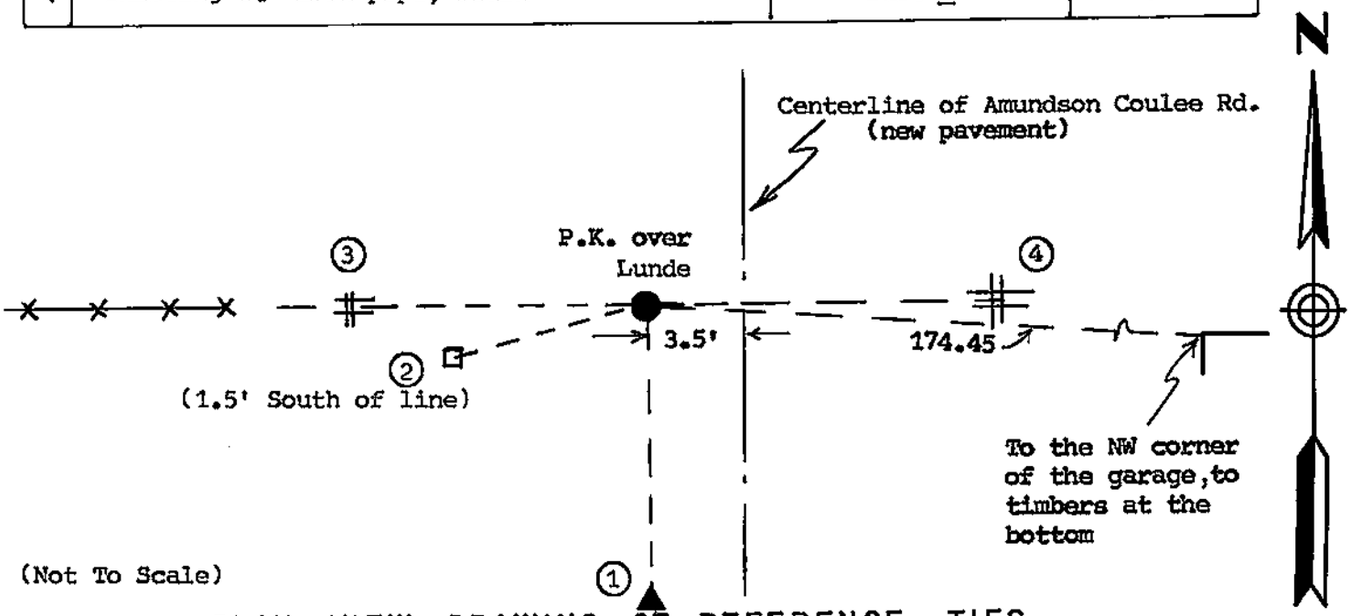

PLAN VIEW DRAWING OF REFERENCE TIES

MAP SHOWING DISTANCE AND DIRECTION TO OTHER PUBLIC LAND SURVEY CORNERS USED FOR REESTABLISHING THE CORNER

(No section measurements were made by me at this time. The West line of Section 22 was measured by Norm Hurlburt.)

I, William C. Jung, ~~Deputy~~ County Surveyor,
HEREBY CERTIFY THAT THE CORNER LOCATION SHOWN ON THIS RECORD WAS DETERMINED BY ME OR UNDER MY DIRECTION AND CONTROL AND THAT THIS U. S. PUBLIC LAND SURVEY MONUMENT RECORD IS CORRECT AND COMPLETE TO THE BEST OF MY KNOWLEDGE AND BELIEF.

William C. Jung
Signature

1/19/89
Date

Revised: 3/8/95 W.C.J.

WISCONSIN
WILLIAM C. JUNG
S-1323
ONALASKA, WIS.
LAND SURVEYOR

Seal