NO. 100

21807222000

U. S. PUBLIC LAND SURVEY MONUMENT RECORD

SECTION 23 T 18 N, R 7 W, TOWN OF Farmington

LA CROSSE COUNTY

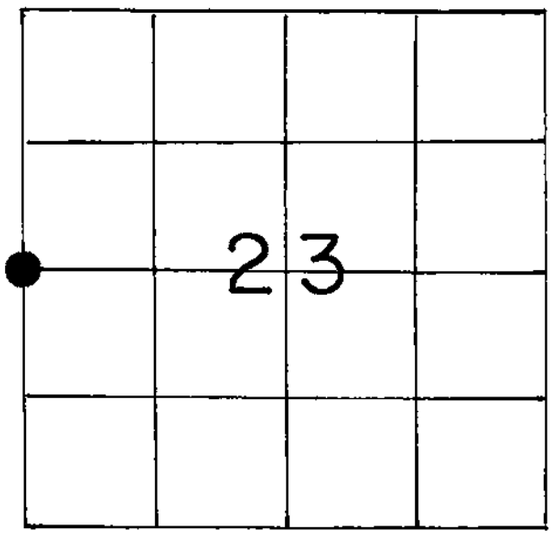

LOCATION OF LANDMARK

WISCONSIN COORDINATE SYSTEM
North
East
Theta Angle
Horiz. Order
Vert. Order

TYPE OF LANDMARK
Brass capped Lunde marker

BEARINGS ARE REFERENCED TO

Crew: William C. Jung
Dan Leis

Date: November 6, 1990

Describe any record evidence, monument evidence, testimonial evidence or any other material evidence you considered and whether the monument was found or restored through acceptance of an obliterated evidence location.

I accepted the old occupied fence corner as the best available evidence of the original government corner position and monumented it with a Lunde marker. I found the remains of the old fence corner post as I dug. A whiskey bottle was buried with the corner. I also found fieldstones 15" to the NW, 26" to the W, and 16" to the SE. Could these three stones have been offsets placed by someone in the past?

Note: Hurlburt and I agree on this position.

Describe or show any material discrepancy between the location of the restored corner and that of the corner previously restored or reestablished.

None known.

RECORD OF DURABLE WITNESS MONUMENTS

NO	DESCRIPTION	BEARING	DISTANCE
1	P.K. nail in single blazed 4" hickory	--------	22.97
2	" 3½" hickory w/sign	--------	7.41
3	" 25" oak	--------	slope=47.09
4	" 18" white oak	--------	54.37

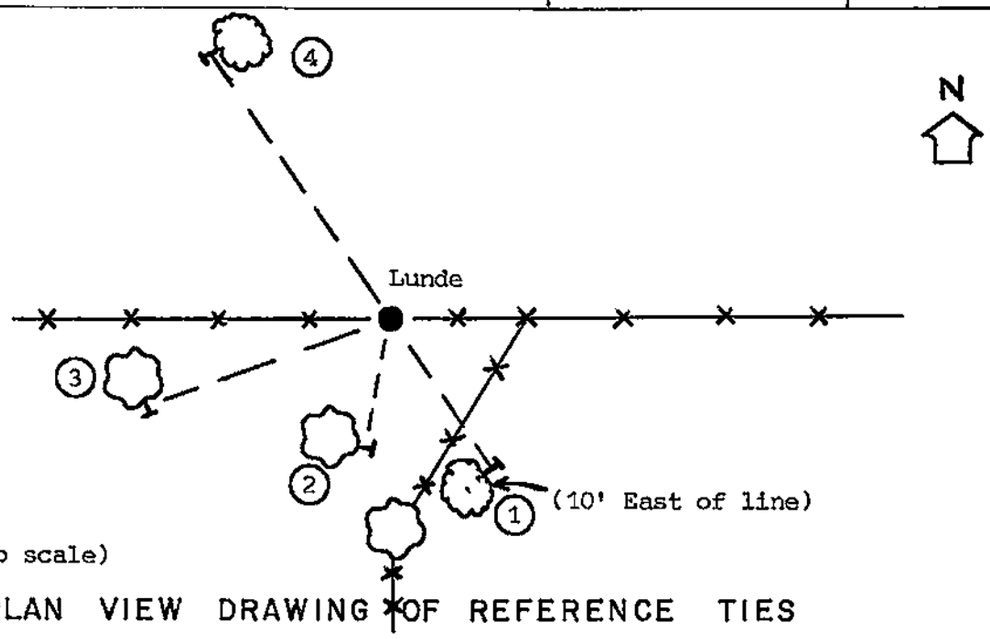

(not to scale)

PLAN VIEW DRAWING OF REFERENCE TIES

MAP SHOWING DISTANCE AND DIRECTION TO OTHER PUBLIC LAND SURVEY CORNERS USED FOR REESTABLISHING THE CORNER

Note: No measurements made by me at this time. Hurlburt measured to this corner. I agree with his conclusions.

I, William C. Jung, Deputy County Surveyor,

HEREBY CERTIFY THAT THE CORNER LOCATION SHOWN ON THIS RECORD WAS DETERMINED BY ME OR UNDER MY DIRECTION AND CONTROL AND THAT THIS U. S. PUBLIC LAND SURVEY MONUMENT RECORD IS CORRECT AND COMPLETE TO THE BEST OF MY KNOWLEDGE AND BELIEF.

William C. Jung — January 10, 1991

Signature — Date

Seal