#87
18-8

21808170000

TREMPEALEAU COUNTY

U.S. PUBLIC LAND SURVEY MONUMENT RECORD

SECTION Corner common to Sections 16, 17, 20 & 21

T. 18 N., R. 8 W.

Type of monument 7/8" X30" REBAR WITH ALUMINUM CAP

Location indicated on sketch – ⊕ –

17	16
20	21

Location Sketch

Describe any record evidence, monument evidence, occupational evidence, testimonial evidence or any other material evidence you considered, and whether the monument was found or placed.

ORIGINAL GOVERNMENT ACCESSORIES WERE SEARCHED FOR, BUT NOTHING WAS FOUND. ALUMINUM CAPPED MONUMENT, CALLED FOR BY R. CHALSMA IN 1986 WAS FOUND APPROXIMATELY AT THE INTERSECTION OF CENTERLINES NORTH AND EAST/WEST, AND APPROXIMATELY 7 FEET WEST OF A CROOKED, REMNANT FENCE LINE SOUTH. DUE TO THIS CORNER POSITION BEING LOCATED IN AN EXISTING ROADBED, IT WAS EXCAVATED WITH BACK HOE IN SEARCH OF SUBSURFACE MONUMENT EVIDENCE. NO OTHER MONUMENT EVIDENCE WAS FOUND. FOUND MONUMENT MATCHES ORIGINAL GOVERNMENT DISTANCE TO THE NORTH QUARTER CORNER OF SECTION 20-18-8 BY LESS THAN 1 FOOT. IT MATCHES ORIGINAL GOVERNMENT DISTANCE TO THE NORTH QUARTER CORNER OF SECTION 21-18-8 BY LESS THAN 1 FOOT. IT ALSO MATCHES ORIGINAL GOVERNMENT DISTANCE TO THE EAST QUARTER CORNER OF SECTION 17-18-8 BY LESS THAN 1 FOOT. THEREFORE, BELIEVING FOUND ALUMINUM MONUMENT TO BE THE BEST AVAILABLE EVIDENCE OF THIS CORNER'S ORIGINAL LOCATION, A 7/8"X30" REBAR WITH AN ALUMINUM CAP WAS SET IN IT'S PLACE AND REFERENCED AS SHOWN BELOW.

Show a plan view drawing depicting the relevant monuments, providing reference ties to at least 4 witness monuments. Describe witness monuments. Show relationship to occupation.

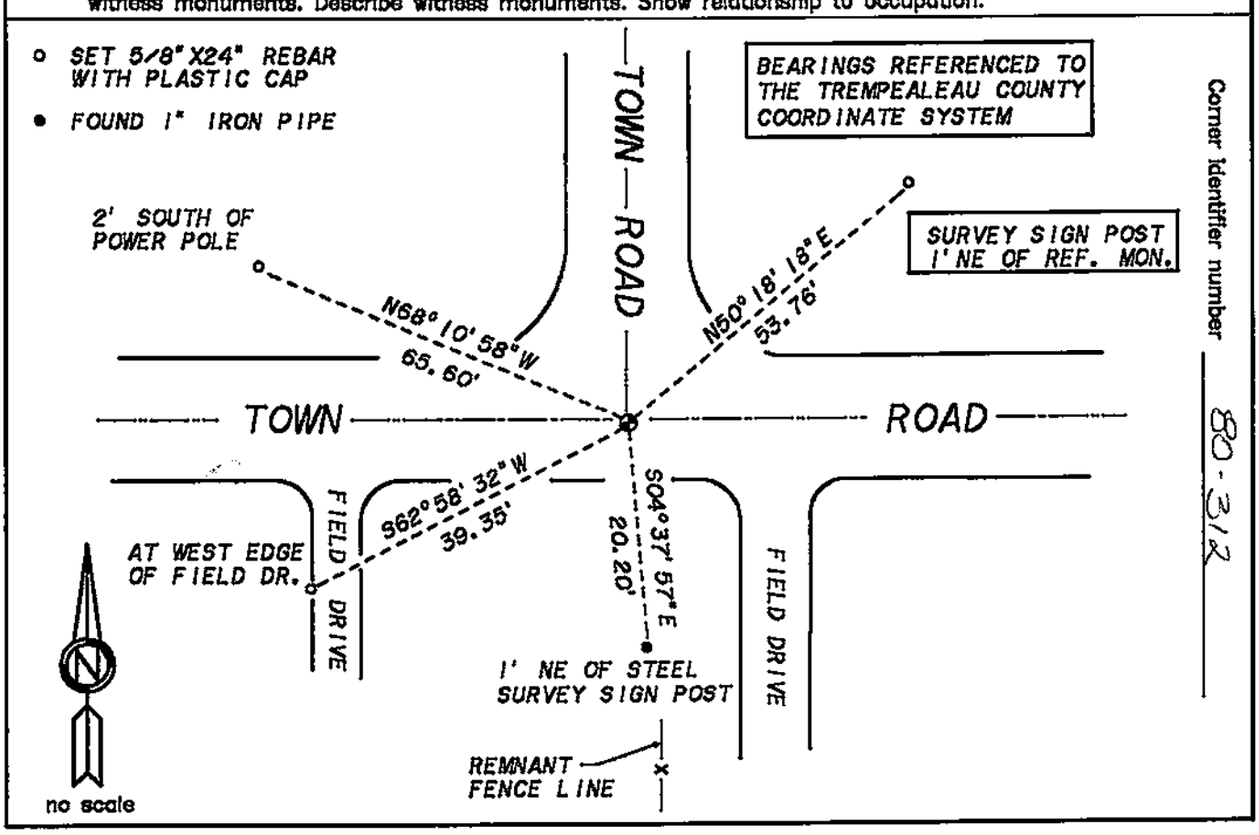

Corner identifier number 80-312

Describe any material discrepancy between the location of the corner as restored or reestablished and the location of that corner as previously restored or reestablished by distance and direction. Show the discrepancy on the plan view drawing. Show the distances between the corner as restored or reestablished, and (1) the corner as restored or reestablished, and (2) to at least 2 of the witness monuments shown on the drawing.

NO MATERIAL DISCREPANCY WAS FOUND.

Was the corner restored through acceptance of (1) an obliterated evidence location, (2) a found perpetuated location, or (3) an existent corner location?

A FOUND PERPETUATED LOCATION.

Was the corner reestablished through lost corner proportionate methods? If so, show the method including the directions and distances to othe public land survey corners used as evidence or used for proportioning in determining the corner location.

NO.

Show the corner history of record in chronological order from Original Government Survey to present.

ORIGINAL GOVERNMENT SURVEY - CYRUS WOODWORTH - SEPTEMBER 1847
SET POST FOR SECTION CORNER. MARKED TWO BEARING TREES.

UNITED STATES ENGINEER OFFICE - WIELDE - JULY 1932
SURVEYS FOR LOCK AND DAM SYSTEM ALONG THE MISSISSIPPI RIVER. TRAVERSES THE EAST LINE OF SECTION 20-18-8. NOTES CALL FOR CENTERLINE INTERSECTION OF ROADS NORTH, EAST AND WEST. NO CORNER FOUND. ALSO INDICATES FENCE LINE SOUTH MATCHING ROAD CENTERLINE TO NORTH VERY CLOSELY.

RECORD OF LAND CORNER PERPETUATION - R. CHALSMA - AUGUST 1986
FILES TIE SHEET FOR THE NORTHEAST CORNER OF SECTION 20-18-8. CALLS FOR SET COUNTY MONUMENT. ALSO SETS FOUR REFERENCE TIES. INFORMATION ON SHEET DOES NOT INDICATED SPECIFIC METHOD OF REESTABLISHMENT.

PRIVATE LAND SURVEYOR'S RECORDS - S. SOLBERG - DECEMBER 1986
SURVEYS PARCEL IN SECTION 16-18-8. SHOWS COUNTY MARKER, APPARENTLY AT THE SOUTHWEST CORNER OF SECTION 16.

PRIVATE LAND SURVEYOR'S RECORDS - S. SOLBERG - JANUARY 1992
SURVEYS PARCEL IN SECTION 21-18-8. SHOWS FOUND COUNTY MARKER AT THE NORTHWEST CORNER OF SECTION 21.

PRIVATE LAND SURVEYOR'S RECORDS - S. SOLBERG - JANUARY 1992
SURVEYS PARCEL IN SECTION 21-18-8. SHOWS SYMBOL AT THE NORTHWEST CORNER OF SECTION 21. INDICATES NORTHWEST CORNER INCORRECTLY AS "NORTHEAST". DOES NOT INDICATE WHAT WAS FOUND OR SET.

PRIVATE LAND SURVEYOR'S RECORDS - S. SOLBERG - JUNE 1996
SURVEYS PARCEL IN SECTION 21-18-8. SHOWS FOUND COUNTY MARKER AT THE NORTHWEST CORNER OF SECTION 21.

Affix Land Surveyor Seal

WISCONSIN
JOSEPH P. NELSEN
S-1602
ELK MOUND, WI
LAND SURVEYOR

I, *JOSEPH P. NELSEN*
certify that the corner location shown on this record was determined by me or under my direction and control and that this U.S. Public Land Survey Monument Record is correct to the best of my knowledge and belief.

Joseph P. Nelsen 9-21-99
Signature Date