21907280000

TREMPEALEAU COUNTY

U.S. PUBLIC LAND SURVEY MONUMENT RECORD

SECTOIN Corner common to Sections 27, 28, 33 & 34

T. 19 N., R. 7 W.

Type of monument 7/8" X 30" REBAR WITH ALUMINUM CAP

Location indicated on sketch – ⊕ –

28	27
33	34

Location Sketch

Describe any record evidence, monument evidence, occupational evidence, testimonial evidence or any other material evidence you considered, and whether the monument was found or placed.

ORIGINAL GOVERNMENT ACCESSORIES WERE SEARCHED FOR, BUT NONE WERE FOUND. OTHER MONUMENT EVIDENCE WAS SEARCHED FOR, BUT NONE WAS FOUND. A POSITION FOR THIS CORNER WAS DETERMINED BASED ON OCCUPATIONAL EVIDENCE, CONSISTING OF THE INTERSECTION OF FENCE LINES WEST AND NORTH. THIS POSITION MATCHES ORIGINAL GOVERNMENT DISTANCE TO THE EAST QUARTER CORNER OF SECTION 28-19-7 BY LESS THAN 3 FEET. IT MATCHES ORIGINAL GOVERNMENT DISTANCE TO THE EAST QUARTER CORNER OF SECTION 33-19-7 BY LESS THAN 7 FEET. IT MATCHES ORIGINAL GOVERNMENT DISTANCE TO THE NORTH QUARTER CORNER OF SECTION 33-19-7 BY LESS THAN 2 FEET. IT MATCHES THE SPLIT OF DISTANCE BETWEEN THE EAST QUARTER CORNER OF SECTION 28-19-7 AND THE EAST QUARTER CORNER OF SECTION 33-19-7 BY LESS THAN 5 FEET. IT MATCHES THE "DOUBLE-OVER" OF DISTANCE BETWEEN THE NORTHEAST AND EAST QUARTER CORNERS OF SECTION 28-19-7 BY ABOUT 4 FEET. IT ALSO MATCHES THE "DOUBLE-OVER" OF DISTANCE BETWEEN THE NORTHWEST AND NORTH QUARTER CORNERS OF SECTION 33-19-7 BY ABOUT 3 FEET. THEREFORE, BELIEVING THIS POSITION, AS DESCRIBED, TO BE THE BEST AVAILABLE EVIDENCE OF THE LOCATION OF THE ORIGINAL GOVERNMENT CORNER, A MONUMENT WAS SET AND REFERENCED AS SHOWN BELOW.

Show a plan view drawing depicting the relevant monuments, providing reference ties to at least 4 witness monuments. Describe witness monuments. Show relationship to occupation.

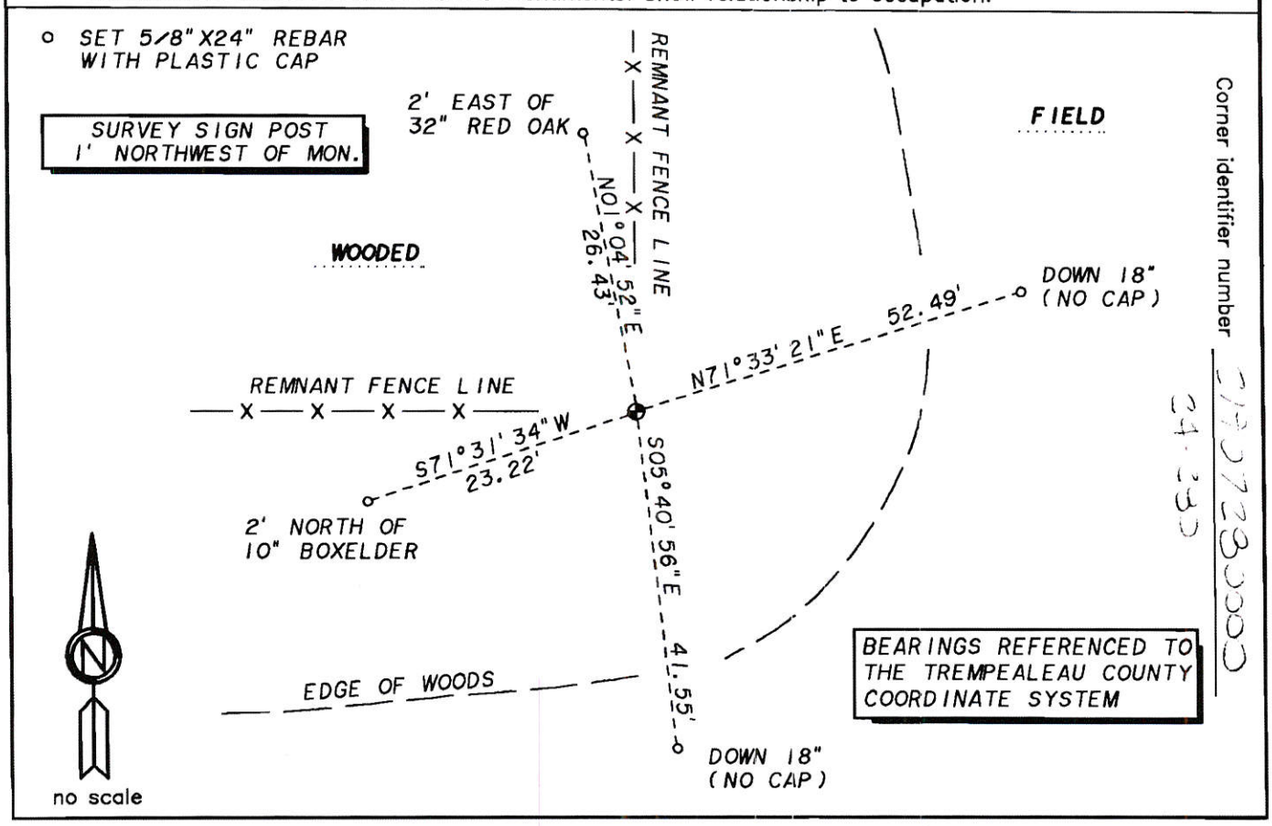

Describe any material discrepancy between the location of the corner as restored or reestablished and the location of that corner as previously restored or reestablished by distance and direction. Show the discrepancy on the plan view drawing. Show the distances between the corner as restored or reestablished, and (1) the corner as restored or reestablished, and (2) to at least 2 of the witness monuments shown on the drawing.

NO MATERIAL DISCREPANCY WAS FOUND.

Was the corner restored through acceptance of (1) an obliterated evidence location, (2) a found perpetuated location, or (3) an existent corner location?

AN OBLITERATED EVIDENCE LOCATION.

Was the corner reestablished through lost corner proportionate methods? If so, show the method including the directions and distances to othe public land survey corners used as evidence or used for proportioning in determining the corner location.

NO.

Show the corner history of record in chronological order from Original Government Survey to present.

ORIGINAL GOVERNMENT SURVEY - C. WOODWORTH - OCTOBER 1847
SET POST FOR SECTION CORNER. MARKED TWO BEARING TREES.

Affix Land Surveyor Seal

I, ***JOSEPH P. NELSEN***
certify that the corner location shown on this record was determined by me or under my direction and control and that this U.S. Public Land Survey Monument Record is correct to the best of my knowledge and belief.

Joseph P. Nelsen — Signature

6-6-02 — Date

WISCONSIN
JOSEPH P. NELSEN
S-1602
ELK MOUND, WI
LAND SURVEYOR