21907330020

TREMPEALEAU COUNTY

U.S. PUBLIC LAND SURVEY MONUMENT RECORD

QUARTER Corner common to Sections 4 & 33

T. 18 & 19 N., R. 7 W.

Type of monument 7/8" X 30" REBAR WITH ALUMINUM CAP

Location indicated on sketch – ⊕ –

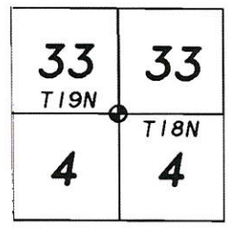

Location Sketch

Describe any record evidence, monument evidence, occupational evidence, testimonial evidence or any other material evidence you considered, and whether the monument was found or placed.

ORIGINAL GOVERNMENT ACCESSORIES WERE SEARCHED FOR, BUT NONE WERE FOUND. OTHER MONUMENT EVIDENCE WAS SEARCHED FOR AND A 5"X21"X36" VERTICAL STONE WAS FOUND APPROXIMATELY ON A REMNANT EAST/WEST FENCE LINE AND APPROXIMATELY 3 FEET EAST OF A CROOKED, REMNANT NORTH/SOUTH FENCE LINE. NO OTHER MONUMENT EVIDENCE WAS FOUND. THIS POSITION MATCHES ORIGINAL GOVERNMENT DISTANCE TO BOTH THE NORTHWEST AND NORTHEAST CORNERS OF SECTION 4-18-7 BY LESS THAN 10 FEET. IT ALSO MATCHES THE SPLIT OF DISTANCE BETWEEN THE NORTHWEST AND NORTHEAST CORNERS OF SECTION 4-18-7 BY LESS THAN 1 FOOT. THEREFORE, BELIEVING FOUND STONE, AS DESCRIBED, TO BE THE BEST AVAILABLE EVIDENCE OF THE LOCATION OF THE ORIGINAL GOVERNMENT CORNER, A MONUMENT WAS SET IN ITS PLACE AND REFERENCED AS SHOWN BELOW.

Show a plan view drawing depicting the relevant monuments, providing reference ties to at least 4 witness monuments. Describe witness monuments. Show relationship to occupation.

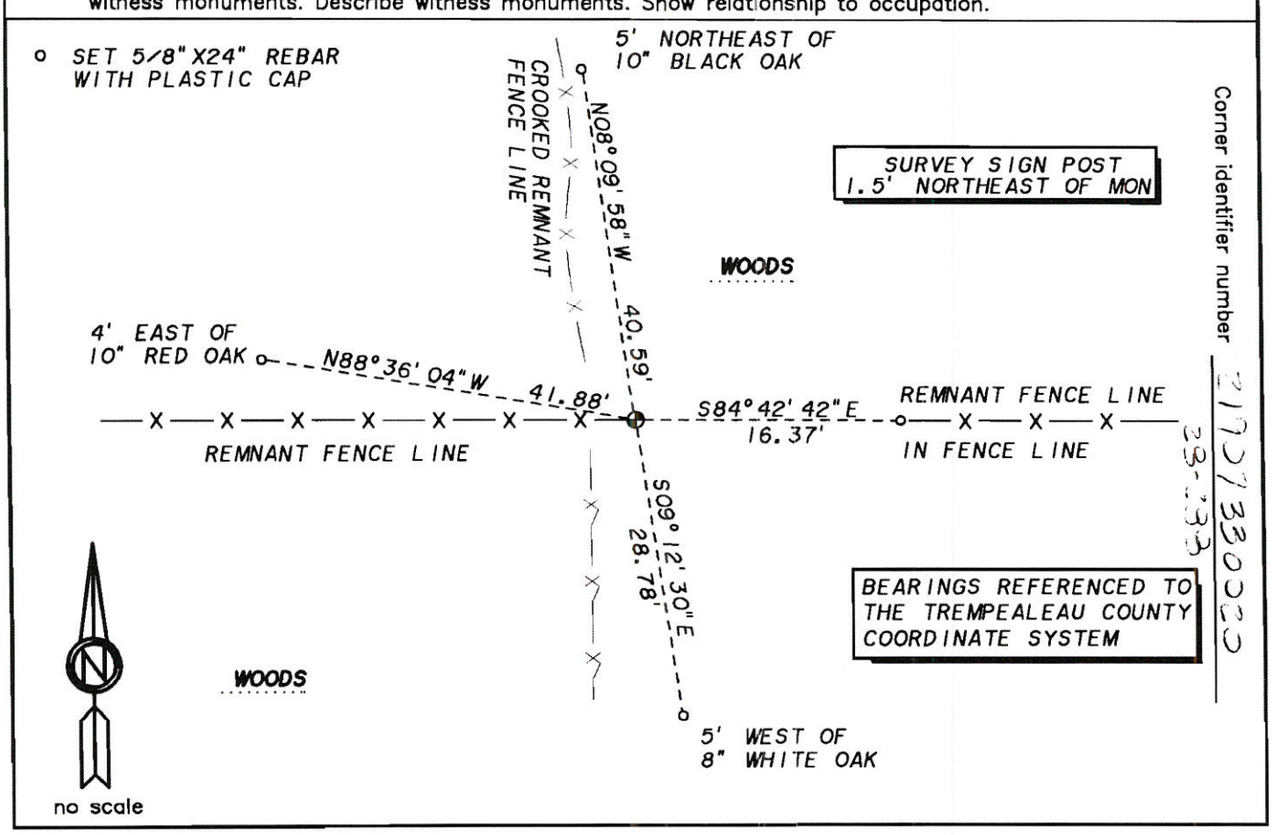

Describe any material discrepancy between the location of the corner as restored or reestablished and the location of that corner as previously restored or reestablished by distance and direction. Show the discrepancy on the plan view drawing. Show the distances between the corner as restored or reestablished, and (1) the corner as restored or reestablished, and (2) to at least 2 of the witness monuments shown on the drawing.

NO MATERIAL DISCREPANCY WAS FOUND.

Was the corner restored through acceptance of (1) an obliterated evidence location, (2) a found perpetuated location, or (3) an existent corner location?

A FOUND PERPETUATED LOCATION.

Was the corner reestablished through lost corner proportionate methods? If so, show the method including the directions and distances to othe public land survey corners used as evidence or used for proportioning in determining the corner location.

NO.

Show the corner history of record in chronological order from Original Government Survey to present.

ORIGINAL GOVERNMENT SURVEY - J.E. FREEMAN - NOVEMBER 1845
SET QUARTER SECTION POST. MARKED TWO BEARING TREES.

Affix Land Surveyor Seal

I, ***JOSEPH P. NELSEN***
certify that the corner location shown on this record was determined by me or under my direction and control and that this U.S. Public Land Survey Monument Record is correct to the best of my knowledge and belief.

Signature

2-13-02
Date

WISCONSIN
JOSEPH P.
NELSEN
S-1602
ELK MOUND,
WI
LAND SURVEYOR